
PLAT OF SURVEY FOR IOWA REALTY
OF THE N. 140.25' OF THE W. 66' OF OUTLOT 15 OF
EAST ADDITION OF OUTLOTS TO THE ORIGINAL TOWN OF
WINTERSET, IOWA

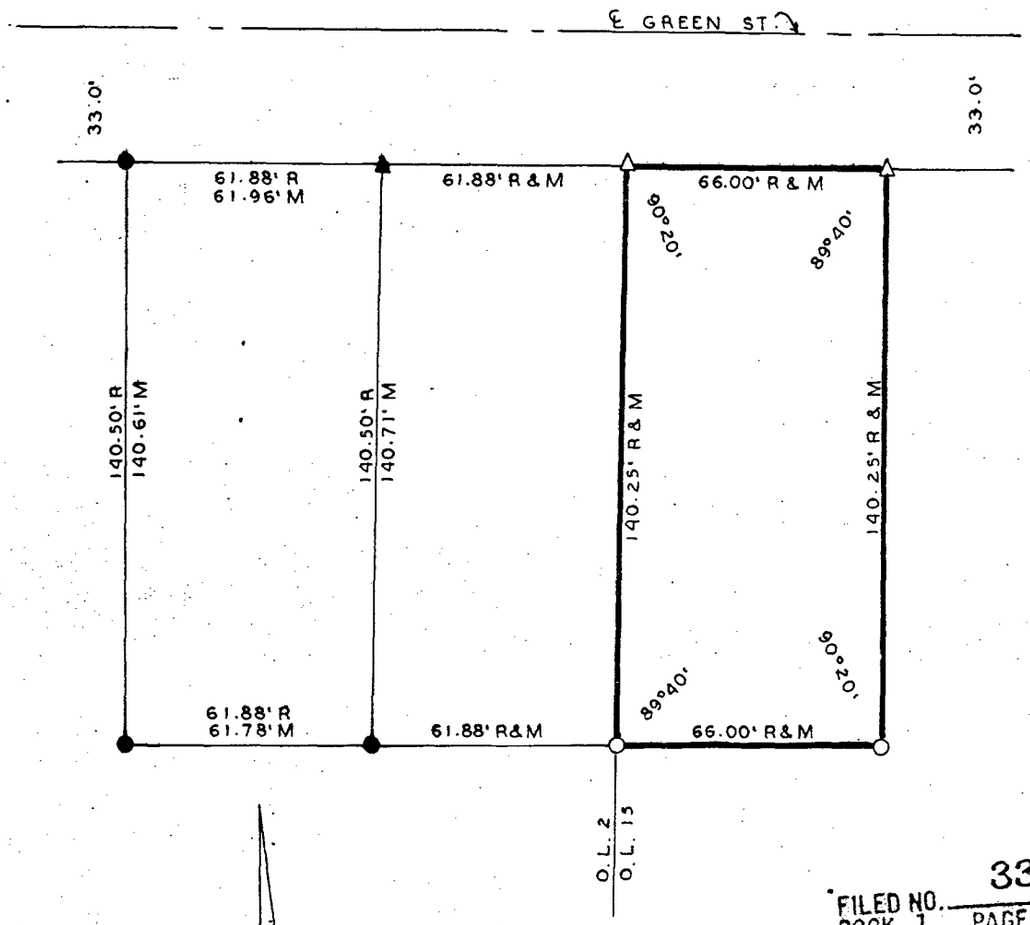

SCALE: 1"=40'

● FOUND C.I.R. #7044

▲ FOUND BLUNCK'S CUT X

Δ CUT AN X

○ SET C.I.R. #8034

R RECORDED DISTANCE

M MEASURED DISTANCE

FILED NO. 339
BOOK 1 PAGE 260
TOWN PLAT
1982 SEP 10 PM 4:14
MARY E. WELTY
RECORDER
MADISON COUNTY, IOWA
Fee $3.00

REGISTERED LAND SURVEYOR
REGISTERED
8034
CLEO E.
McCALL
IOWA

I hereby certify that this plat, map, survey or report was made by me or under my direct personal supervision and that I am a duly registered Land Surveyor under the laws of the State of Iowa.

Signed Cleo E. McCall Date 8-6 1982

CLEO E. McCALL, P. L. S. IOWA REG. NO. 8034

VANCE & HOCHSTETLER, P.C.
CONSULTING ENGINEERS
WINTERSET, IOWA