
PLAT OF SURVEY FOR CITY OF TRURO, IOWA OF THAT PORTION OF PRAIRIE STREET EAST OF RAILROAD STREET

539
FILED NO. 1 BOOK 1 PAGE 261
TOWN PLAT
1982 OCT 19 PM 12:22
MARY E. WELTY
RECORDER
MADISON COUNTY, IOWA
Fee $3.00

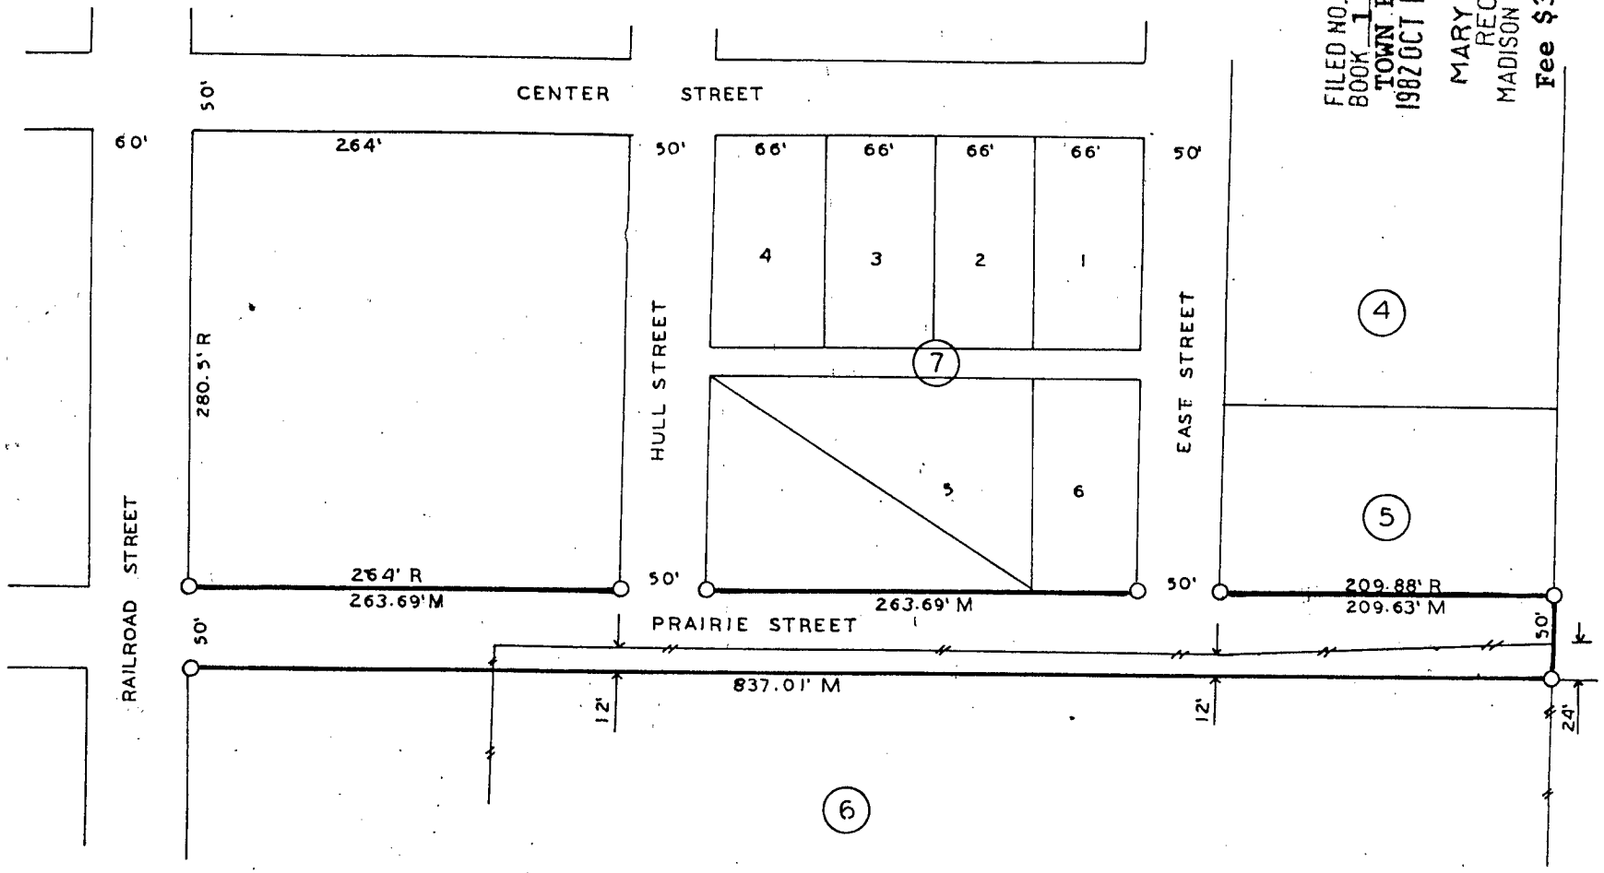



SCALE: 1"=100'

O SET C.I.R. #8034

R RECORDED DISTANCE

M MEASURED DISTANCE

EXISTING FENCE

REGISTERED LAND SURVEYOR
REGISTERED
8034
CLEO E.
McCALL
IOWA

I hereby certify that this survey was made by me or under my direct personal supervision and that I am a duly registered Land Surveyor under the laws of the State of Iowa.

Signed Cleo E. McCall Date 9-22 19 82

CLEO E. McCALL, P.E. & L.S. Iowa Reg. No. 8034

VANCE & HOCHSTETLER, P.C.
CONSULTING ENGINEERS
WINTERSET, IOWA

261