
STATE OF IOWA, MADISON COUNTY, ss. Inst. No. 769 Filed for Record this 6 day of December 19 82 at 10:47 A.M.
Book 1 Page 262 Recording Fee 3.00 Mary E. Welty, Recorder. By m welty Deputy

Town Plat

PLAT OF A SURVEY MADE FOR J. & D. RENTALS
IN LOTS 18 AND 19 OF HUTCHINGS ADDITION
WINTERSET, IOWA

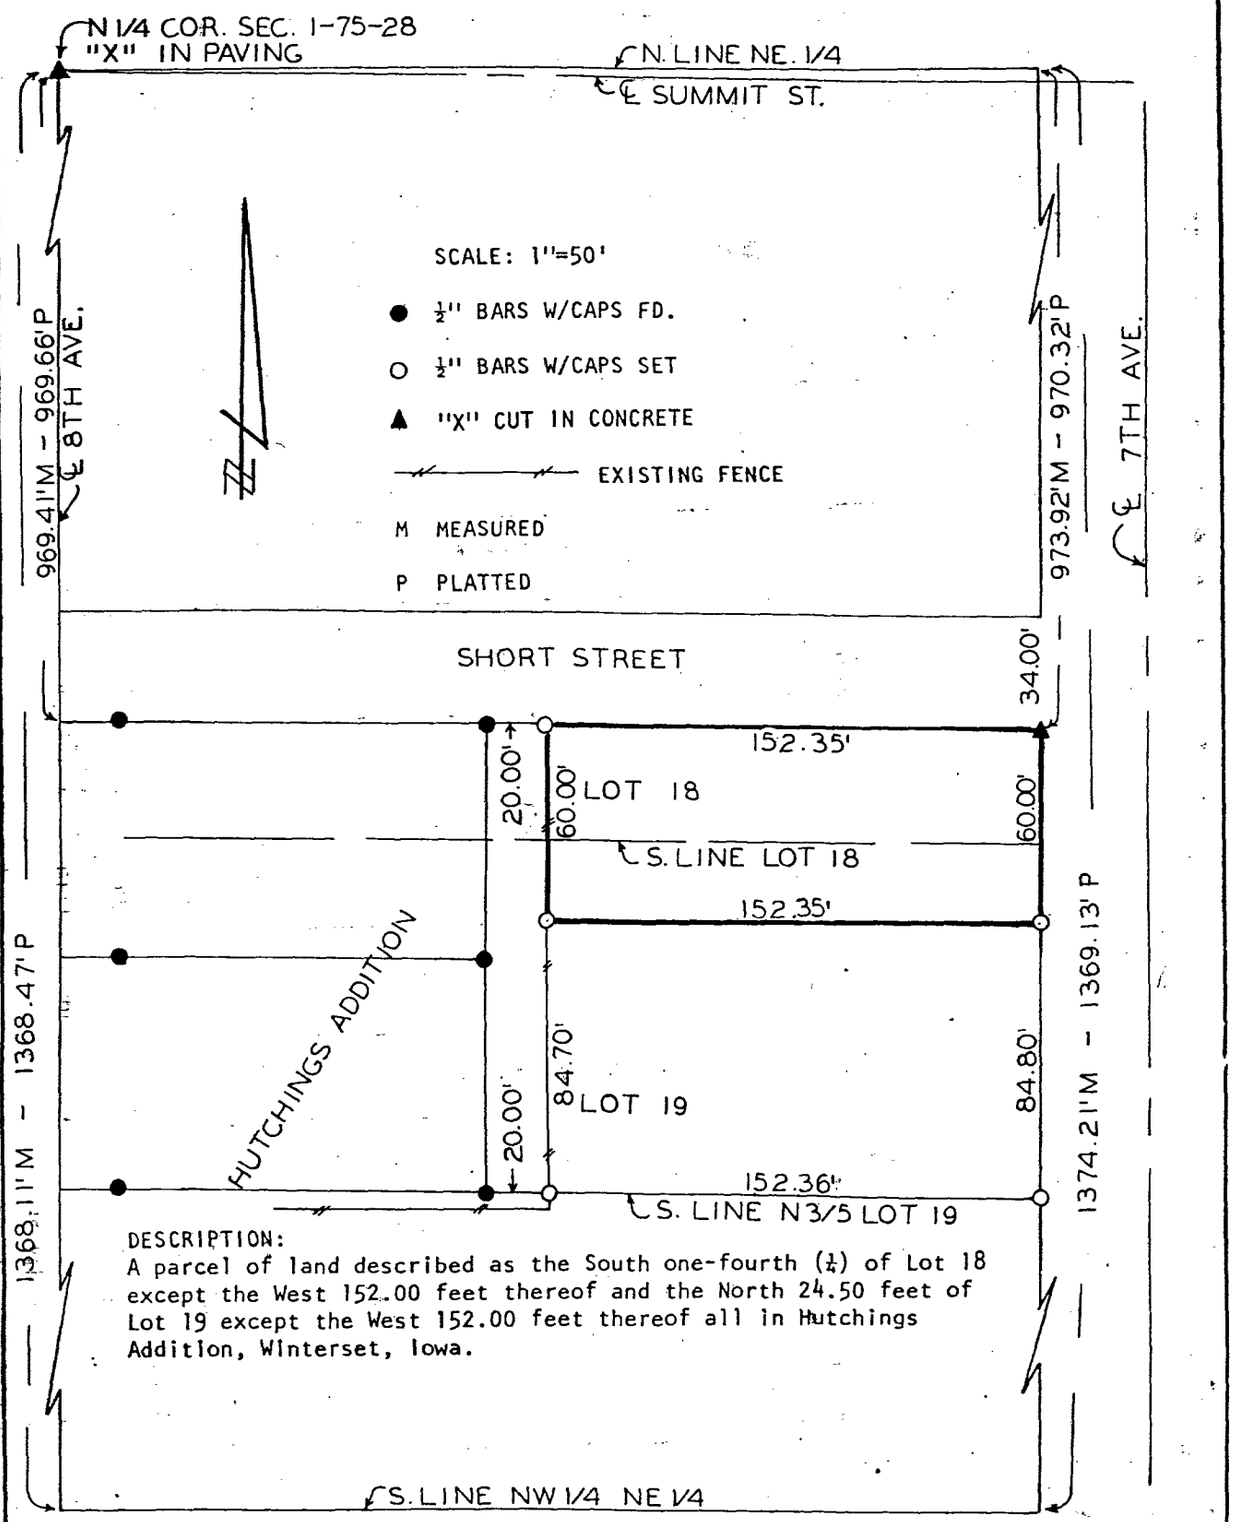

DESCRIPTION:
A parcel of land described as the South one-fourth (¼) of Lot 18 except the West 152.00 feet thereof and the North 24.50 feet of Lot 19 except the West 152.00 feet thereof all in Hutchings Addition, Winterset, Iowa.

I HEREBY CERTIFY THAT THIS PLAN, SPECIFICATION, PLAT, MAP, SURVEY OR REPORT WAS MADE BY ME OR UNDER MY DIRECT PERSONAL SUPERVISION AND THAT I AM A DULY REGISTERED PROFESSIONAL ENGINEER AND LAND SURVEYOR UNDER THE LAWS OF THE STATE OF IOWA
SIGNED J M Hochstetler DATE 9/30/82
J M Hochstetler P.E. & L.S. Iowa Reg No 6000

VANCE & HOCHSTETLER, P.C.
CONSULTING ENGINEERS
WINTERSET, IOWA