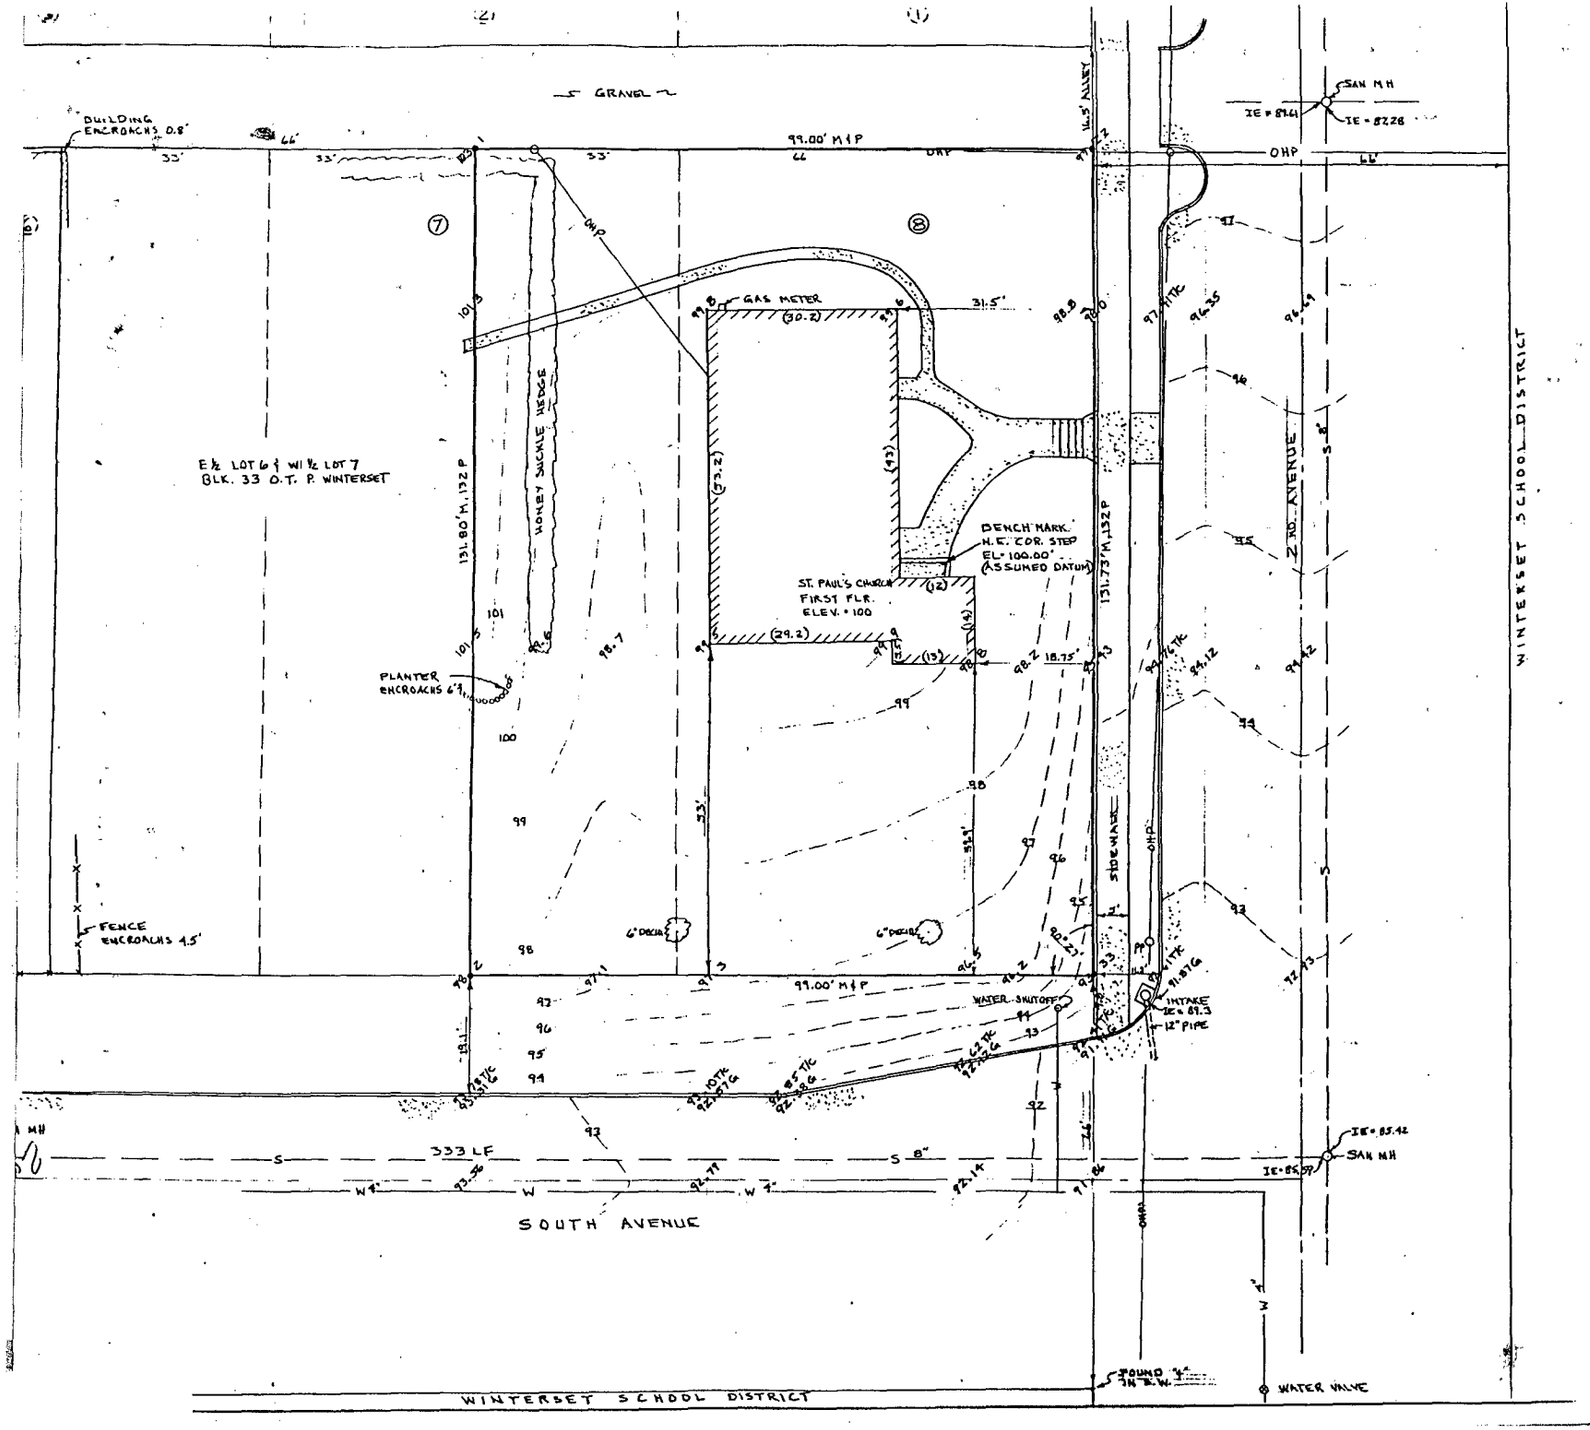


N

1" = 20'

LEGAL DESCRIPTION

THE EAST ONE-HALF (E½) OF LOT SEVEN (7) AND ALL OF LOT EIGHT (8) IN BLOCK THIRTY-THREE (33) OF THE ORIGINAL TOWN PLAT OF WINTERSET, MADISON COUNTY, IOWA.

LEGEND

131.80 M	MEASURED DIMENSION
132 P	PLATTED DIMENSION
•	PROPERTY CORNER SET
+	PROPERTY CORNER FOUND
98.2	EXISTING ELEVATION
—99—	EXISTING CONTOUR
— S 8" —	SANITARY SEWER
—OHP—	OVERHEAD POWER
— W 1" —	WATER

FILED NO. 1480
BOOK 1 PAGE 263
TOWN PLAT
1983 MAR 28 PM 4:13

MARY L. WELTY
RECORDER
MADISON COUNTY, IOWA
Fee $3.00

CERTIFICATION

I HEREBY CERTIFY THAT THIS SURVEY WAS MADE BY ME OR UNDER MY DIRECT PERSONAL SUPERVISION AND THAT I AM A DULY REGISTERED PROFESSIONAL ENGINEER AND LAND SURVEYOR UNDER THE LAWS OF THE STATE OF IOWA.

Darrell M Nielsen Feb 28 1983
DARRELL M NIELSEN PE & L.S. # 6886

DARRELL M. NIELSEN 6886 IOWA

SITE SURVEY	
SCALE: 1" = 20'	APPROVED BY
DATE: 2-28-83	DRAWN BY DHN
ST PAUL'S LUTHERAN CHURCH WINTERSET, IOWA	
Butts Engineering Company Des Moines, Iowa	DRAWING NUMBER 8312