
PLAT OF SURVEY FOR DICK COOPER
OF LOT 6 AND THE WEST HALF
OF LOT 7, BLOCK 4, LAUGHRIDGE &
CASSIDAY'S ADDITION TO THE CITY OF
WINTERSET, IOWA

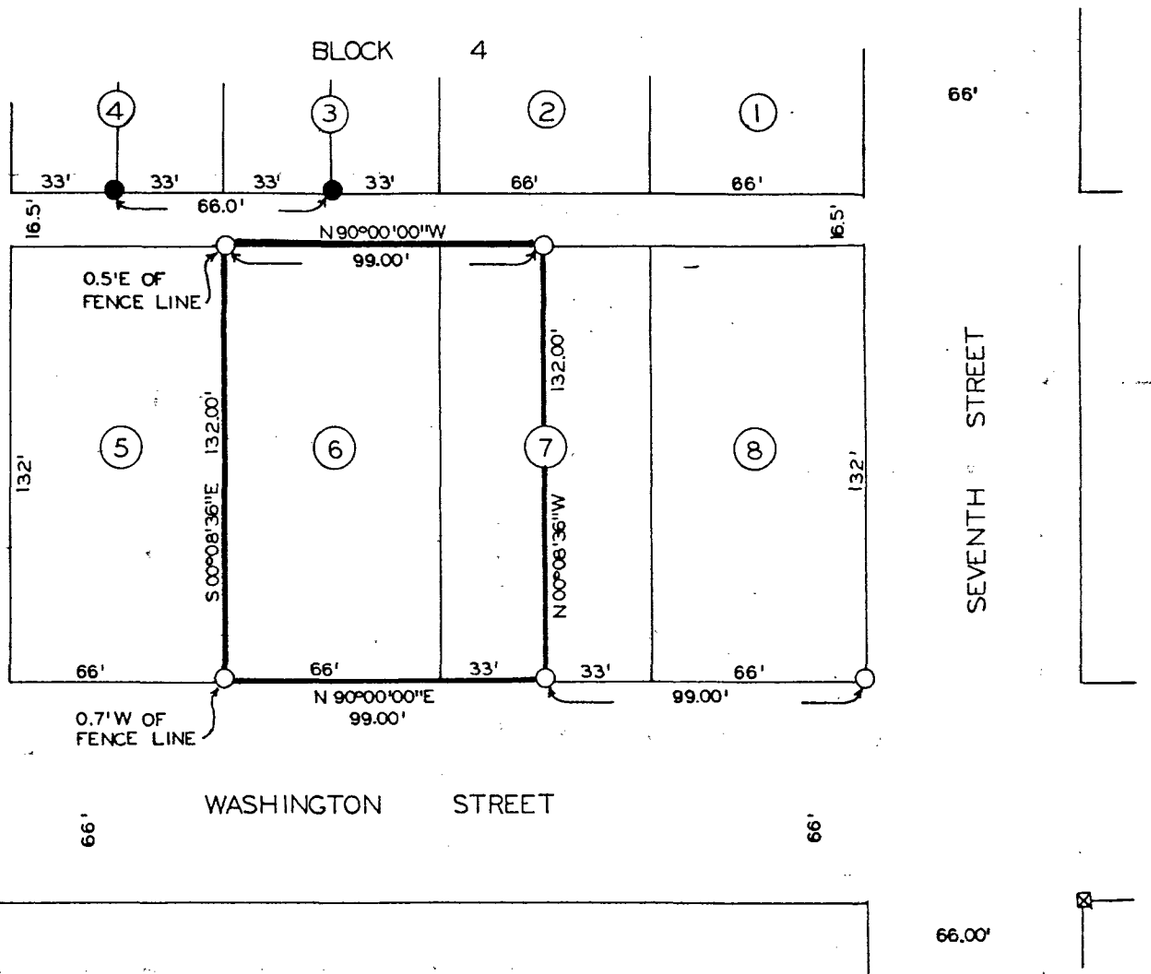

● FOUND C.I.R. #5041

○ SET C.I.R. #8034

⊠ FOUND CUT X

SCALE: 1" = 50'

REGISTERED LAND SURVEYOR
REGISTERED
8034
CLEO E.
McCALL
IOWA

FILED NO. 2116
BOOK 1 PAGE 264
Town Plat
1983 JUN 16 PM 3:30

MARY E. WELTY
RECORDER
MADISON COUNTY, IOWA
Fee $3.00

I hereby certify that this plat, map, survey or report was made by me or under my direct personal supervision and that I am a duly registered Land Surveyor under the laws of the State of Iowa.

Signed Cleo E. McCall Date 4-21 19 83

CLEO E. McCALL, R.L.S. IOWA REG. NO. 8034

VANCE & HOCHSTETLER, P.C.
CONSULTING ENGINEERS
WINTERSET, IOWA 50273