
PLAT OF SURVEY FOR JIM COOK
OF LOT 19, BLOCK 3, DANFORTH'S 2ND ADDITION TO
WINTERSET, IOWA

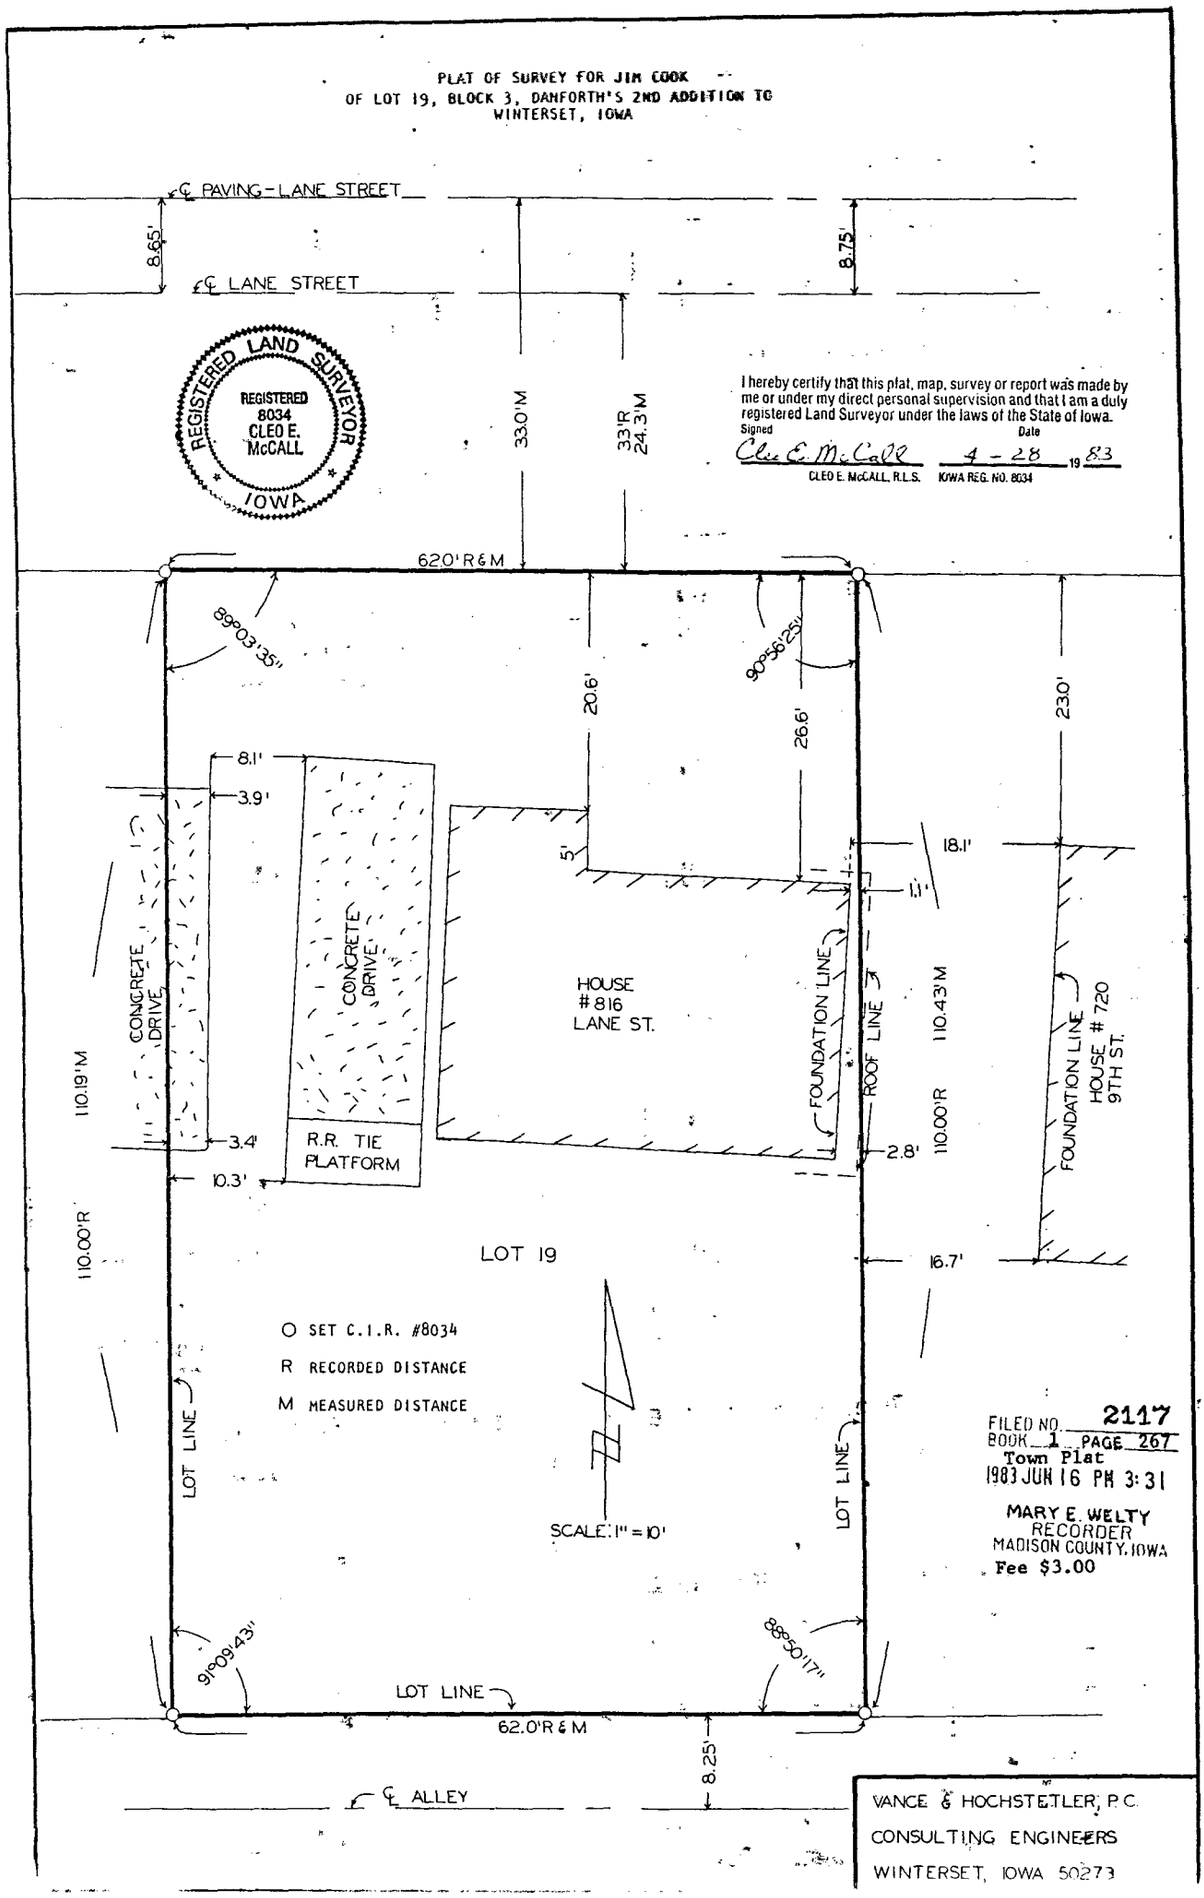

FILED NO. 2117
BOOK 1 PAGE 267
Town Plat
1983 JUN 16 PM 3:31
MARY E. WELTY
RECORDER
MADISON COUNTY, IOWA
Fee $3.00

VANCE & HOCHSTETLER, P.C.
CONSULTING ENGINEERS
WINTERSET, IOWA 50273