

# SURVEY FOR EARL BEARD ESTATE

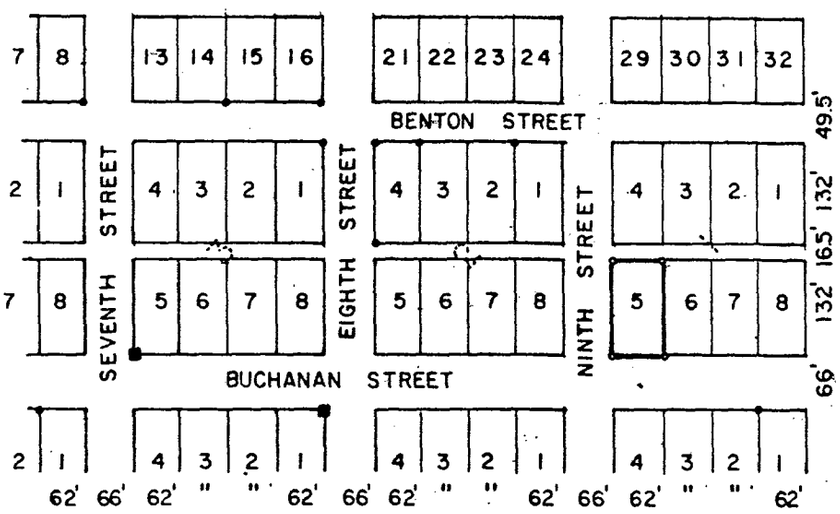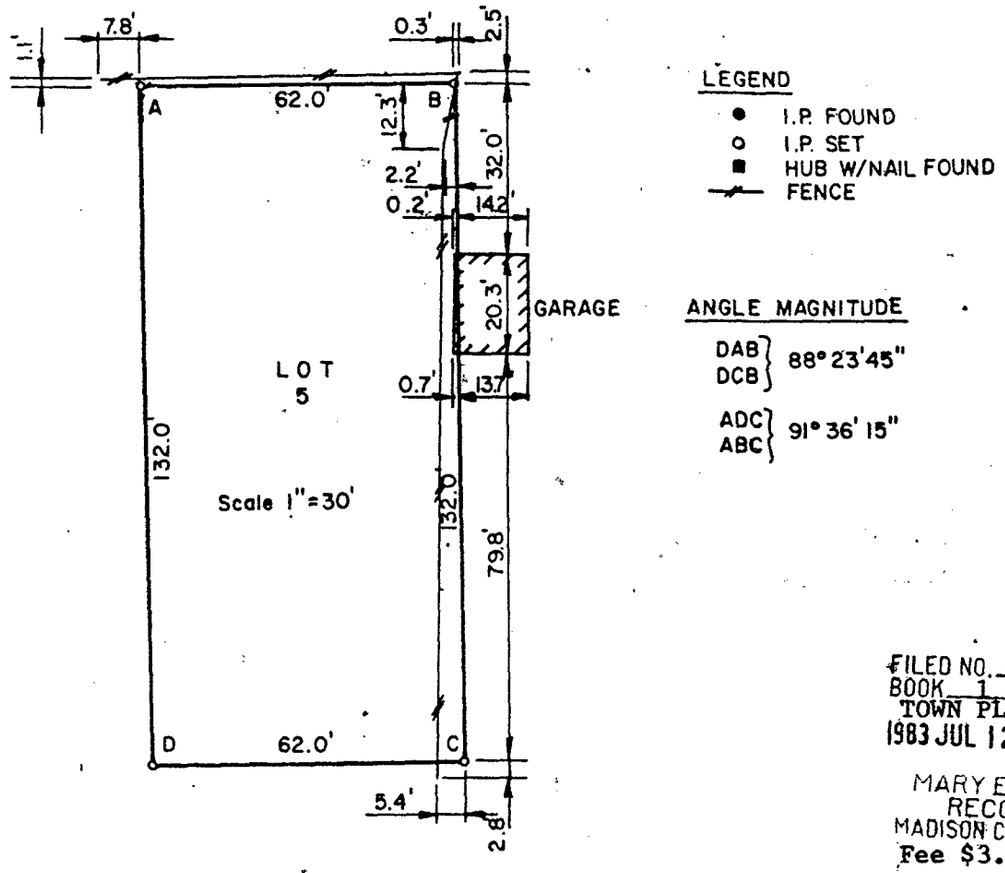


FILED NO. 79
BOOK 1 PAGE 268
TOWN PLAT
1983 JUL 12 AM 11:34
MARY E. WELTY
RECORDER
MADISON COUNTY, IOWA
Fee $3.00

I, TEDDE R. BLUNCK, REGISTERED ENGINEER AND LAND SURVEYOR IN THE STATE OF IOWA, HEREBY CERTIFY THAT ON JULY 2, 1983 I SURVEYED THE FOLLOWING DESCRIBED PROPERTY:

LOT 5, BLOCK 1, DANFORTH'S ADDITION TO WINTERSET, IOWA
AND SUBJECT TO ENCUMBRANCES OF RECORD

AND LOCATED THE PROPERTY LINES AND SET ½" DIAMETER IRON PINS AT THE CORNERS THEREOF AND THAT THIS PLAT WAS PREPARED FROM THE FIELD NOTES OF SAID SURVEY AND THAT I AM COMPETENT TO PREPARE THIS DOCUMENT.

TEDDE R. BLUNCK REGISTERED IOWA

SIGNED T. R. Blunck DATED July 12, 1983

TEDDE R. BLUNCK, P.E., R.L.S. IOWA REGISTRATION NO. 7044