
PLAT OF SURVEY FOR JOE H. McADOW
OF LOT 6, BLOCK 5
ORIGINAL TOWN OF WINTERSET, IOWA

FILED NO. 203
BOOK 1 PAGE 270
TOWN PLAT
1983 JUL 28 PM 2:38
MARY E. WELTY
RECORDER
MADISON COUNTY, IOWA
Fee $3.00

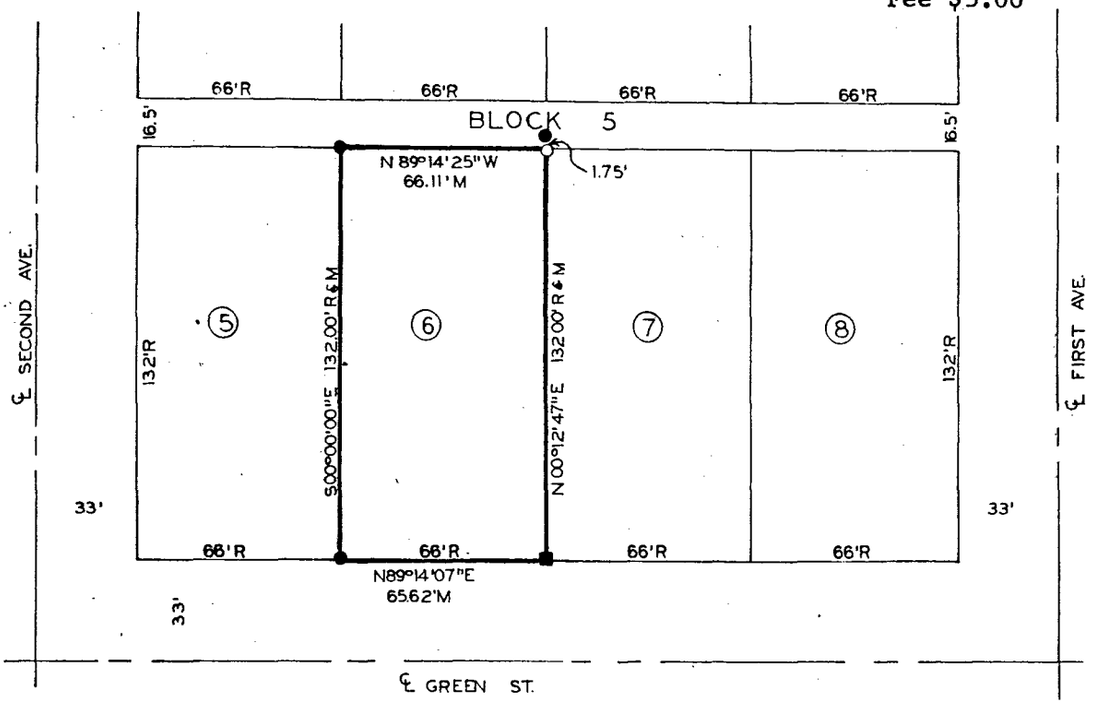


● FOUND 3/4" REBAR

■ FOUND BENT 1/2" REBAR
& RAISED WITH C.I.R. #8034

o SET C.I.R. #8034

R RECORDED DISTANCE

M MEASURED DISTANCE

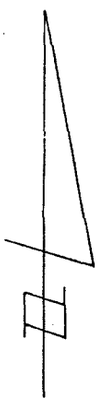

SCALE: 1"=50'

REGISTERED LAND SURVEYOR
REGISTERED
8034
CLEO E.
McCALL
IOWA

I hereby certify that this plat, map, survey or report was made by me or under my direct personal supervision and that I am a duly registered Land Surveyor under the laws of the State of Iowa.

Signed Cleo E. McCall Date 7-6 19 83

CLEO E. McCALL, R.L.S. IOWA REG. NO. 8034

VANCE & HOCHSTETLER, P.C.
CONSULTING ENGINEERS
WINTERSET, IOWA 50273