
PLAT OF SURVEY FOR DALE ATKINSON
OF LOTS 8, 9, & 10 AND THE WEST
38.75 FEET OF LOTS 15 & 16, ALL IN
STEWART'S FIRST ADDITION TO EAST PERU,
MADISON COUNTY, IOWA

FILED NO. 204
BOOK 1 PAGE 271
TOWN PLAT
1983 JUL 28 PM 2:39
MARY E. WELTY.
RECORDER
MADISON COUNTY, IOWA
Fee $3.00

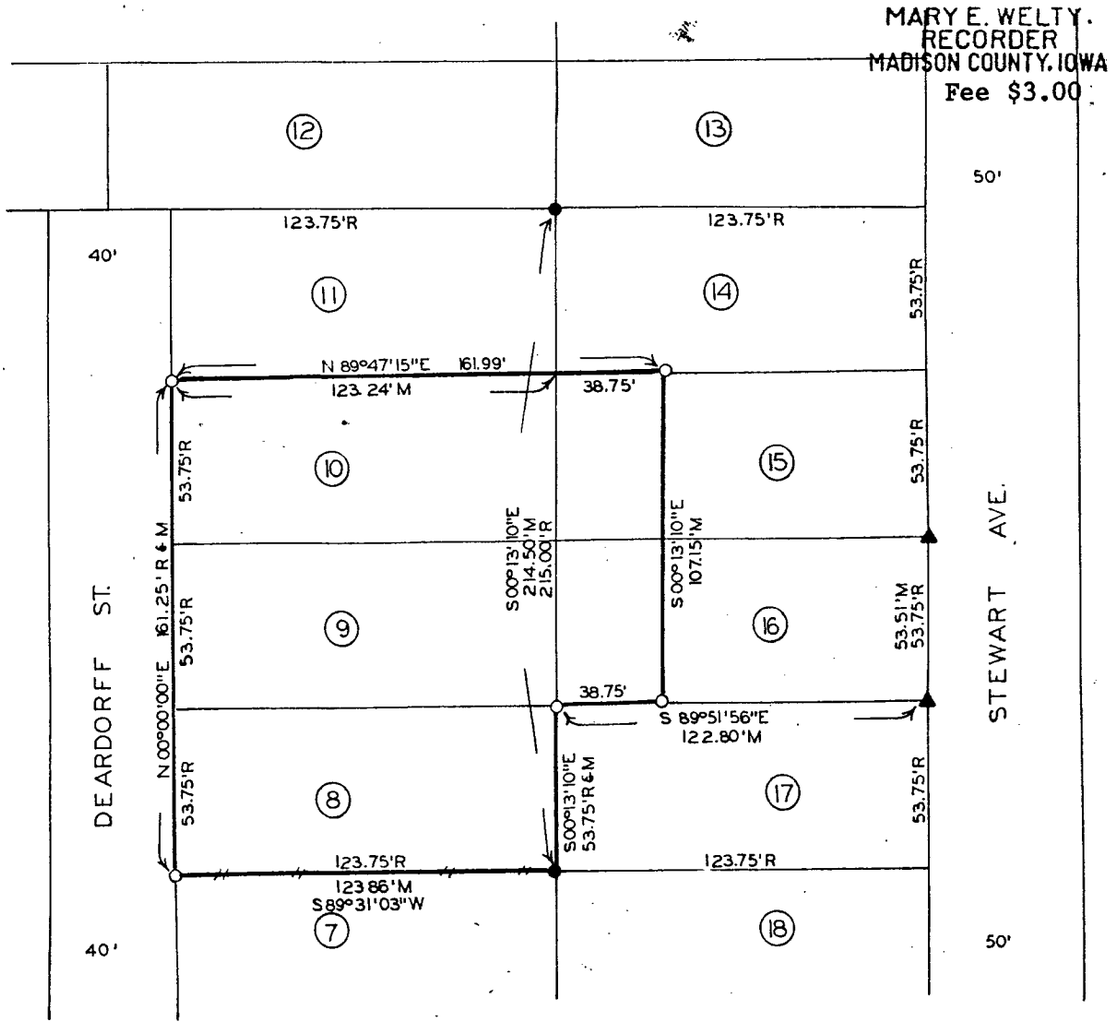

▲ FOUND ROUND BOLT
● FOUND C.I.R. #5041
○ SET C.I.R. #8034
EXISTING FENCE
R RECORDED DISTANCE
M MEASURED DISTANCE

REGISTERED LAND SURVEYOR
REGISTERED
8034
CLEO E.
McCALL
IOWA

SCALE: 1" = 50'

I hereby certify that this plat, map, survey or report was made by me or under my direct personal supervision and that I am a duly registered Land Surveyor under the laws of the State of Iowa.

Signed Cleo E. McCall Date 7-7 19 83

CLEO E. McCALL, R.L.S. IOWA REG. NO. 8034

VANCE & HOCHSTETLER, P.C.
CONSULTING ENGINEERS
WINTERSET, IOWA 50273