
PLAT OF A SURVEY MADE FOR CITY OF TRURO, IOWA
OF EAST STREET FROM PRAIRIE STREET TO NORTH STREET

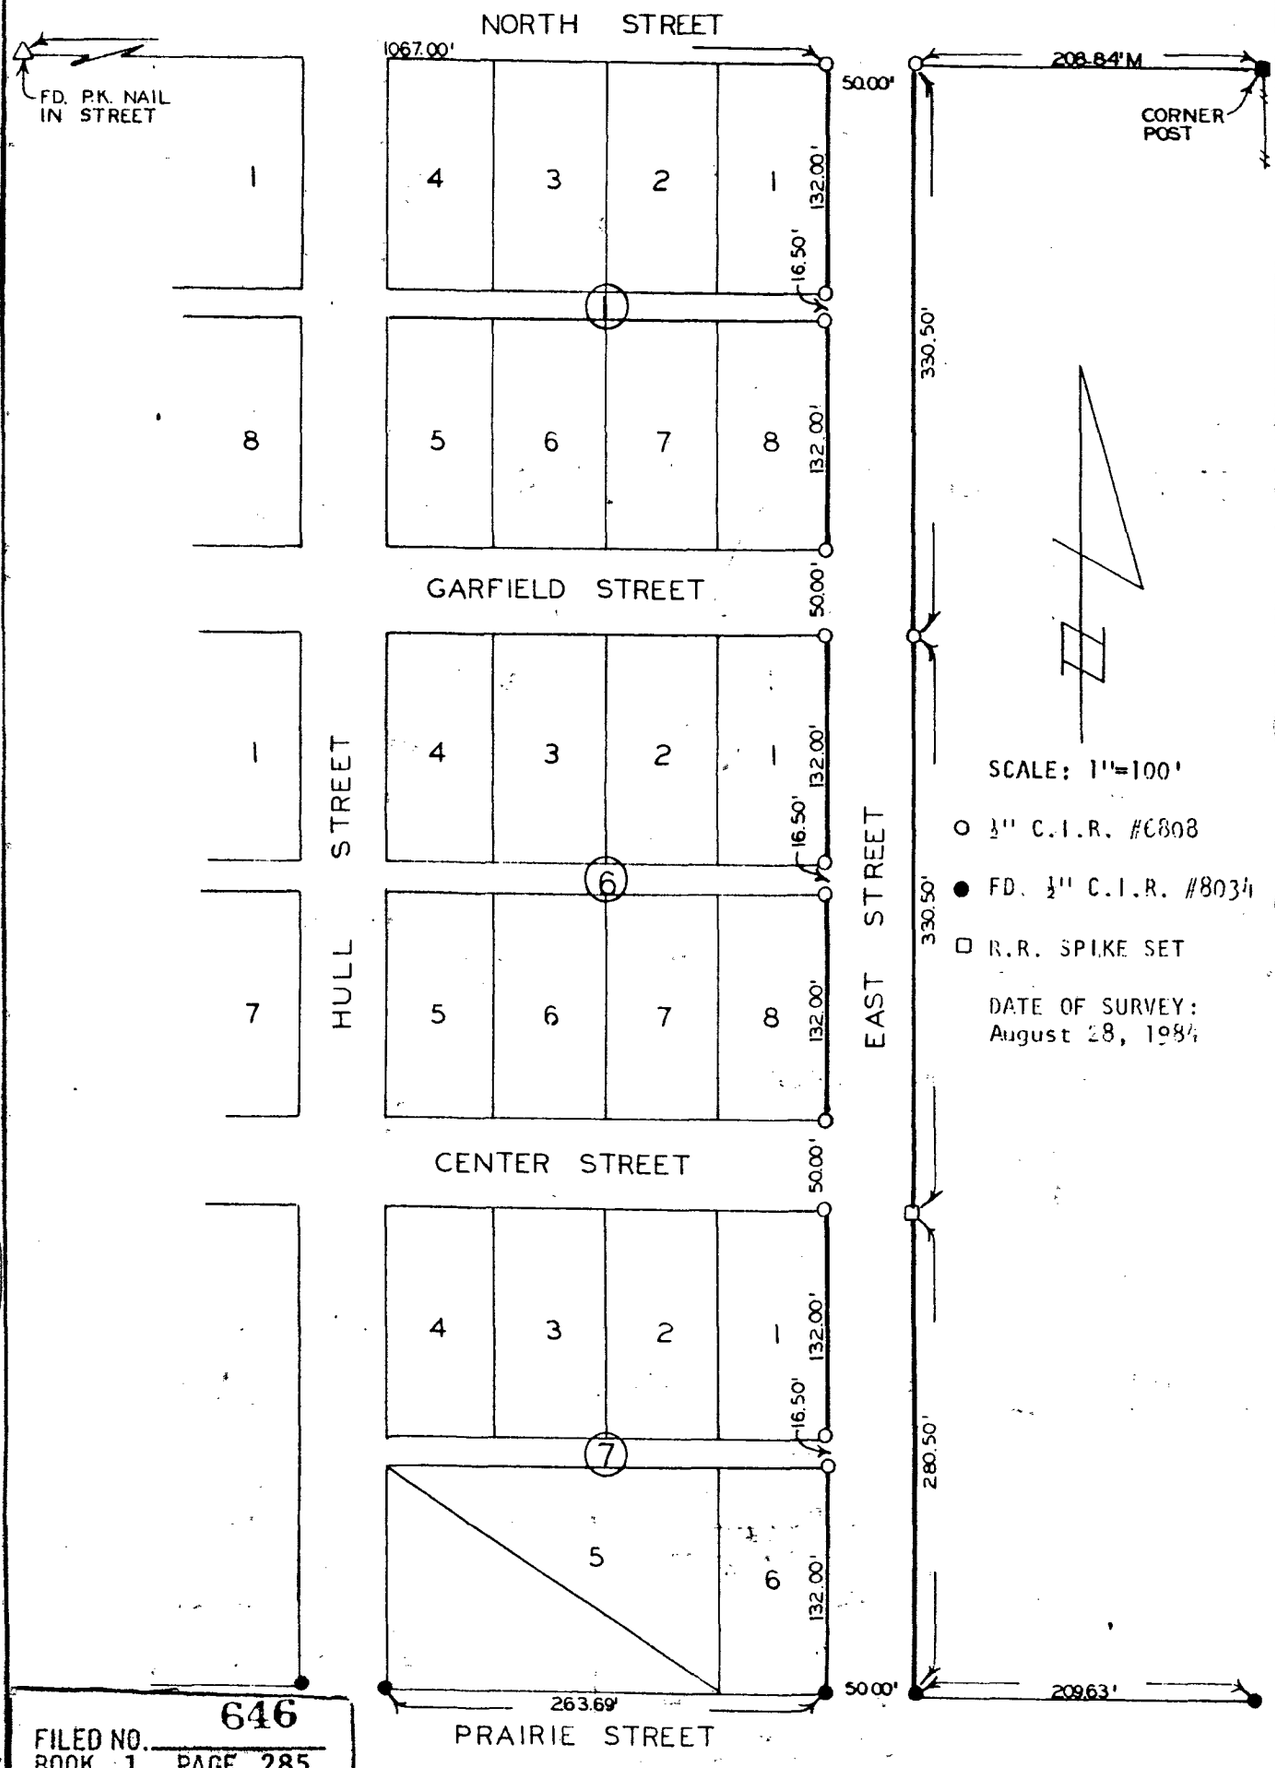

646

FILED NO. _____
BOOK 1 PAGE 285
TOWN PLAT
1984 NOV -2 AM 7:38

MARY E. WELTY
RECORDER
MADISON COUNTY, IOWA

Fee $5.00

I hereby certify that this land survey was prepared by me or under my direct personal supervision and that I am a duly registered Land Surveyor under the laws of the State of Iowa

Signed J. M. Hochstetler

J. M. Hochstetler, P.E., L.S. Iowa Reg. No. 6808

Date 9/21 1984

VANCE & HOCHSTETLER, P.C.
CONSULTING ENGINEERS
WINTERSET, IOWA 50273