
PLAT OF A SURVEY MADE FOR MERVIN BRO
IN BLOCK 24 OF THE ORIGINAL TOWN OF
WINTERSET, MADISON COUNTY, IOWA

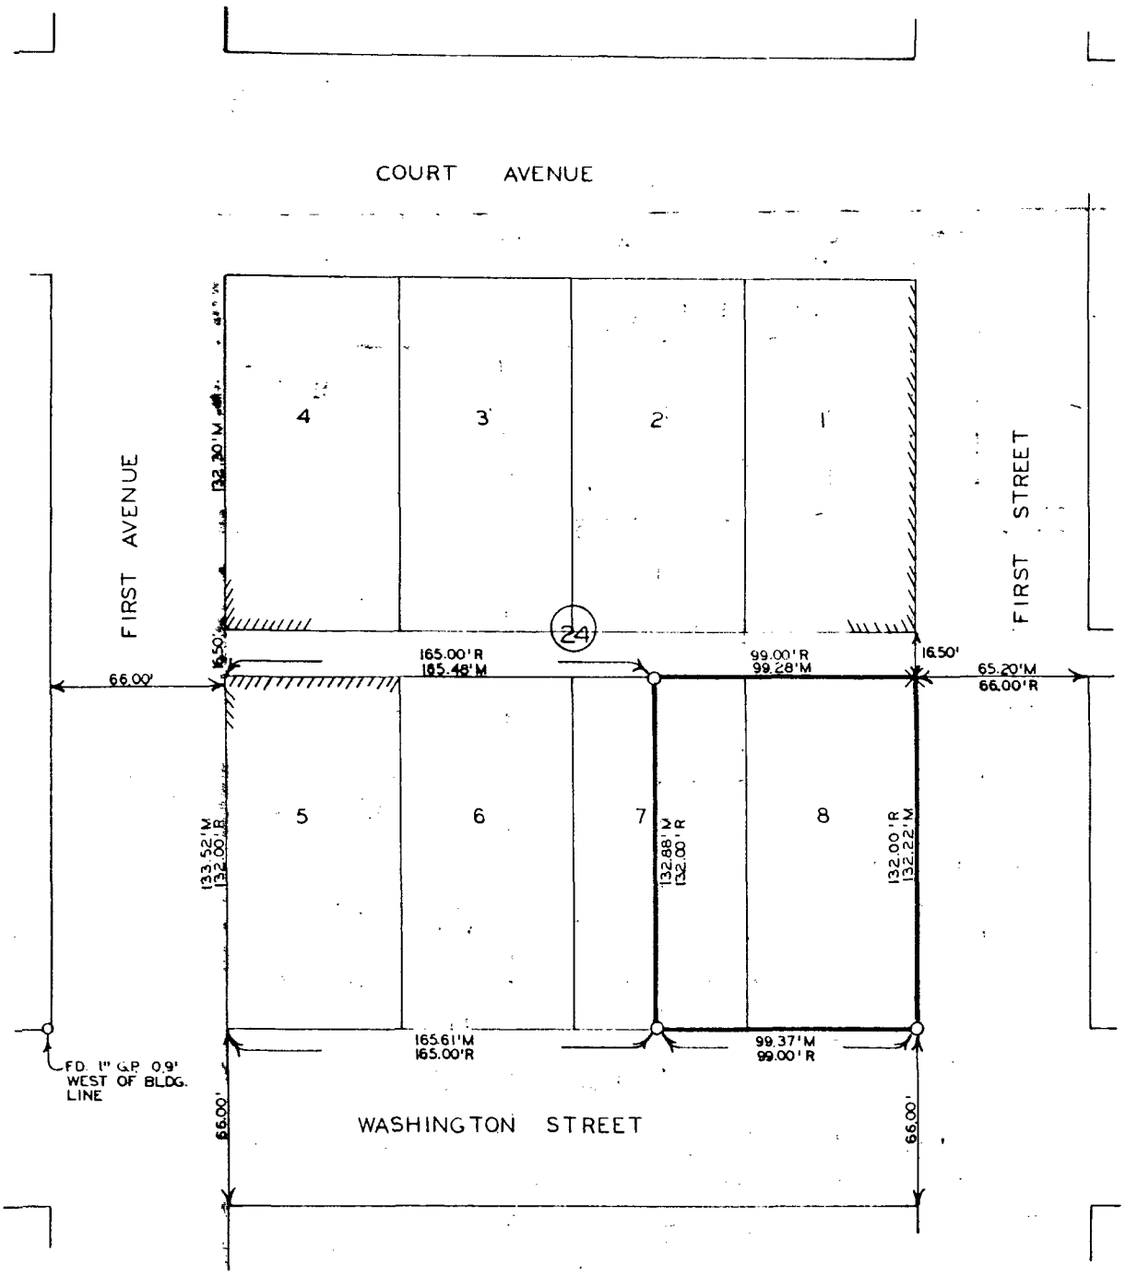

LEGAL DESCRIPTION:
Lot 8 and the East One-Half of Lot 7 in Block 24 of the Original Town of Winterset, Madison County, Iowa.

FILED NO. 647
BOOK 1 PAGE 286
TOWN PLAT
1984 NOV -2 AM 7:39
MARY E. WELTY
RECORDER
MADISON COUNTY, IOWA
Fee $5.00

I hereby certify that this plat, map, survey or report was made by me or under my direct personal supervision and that I am a duly registered Land Surveyor under the laws of the State of Iowa

Signed Jim Hochstetler Date 9/24 1984

J. M. Hochstetler, P.E., L.S. Iowa Reg. No. 6808

SCALE: 1"=50'

X CUT "X" IN CONC.

O SET C.I.R. #6808

R RECORDED DISTANCE

M MEASURED DISTANCE

DATE OF SURVEY: 9/21/84

VANCE & HOCHSTETLER, P.C.
CONSULTING ENGINEERS
WINTERSET, IOWA 50273