
PLAT OF A SURVEY MADE FOR IOWA REALTY
OF LOT 10, PLAT NO. 2,
HELEN MC CALL HUNTOON ADDITION TO
WINTERSET, MADISON COUNTY, IOWA

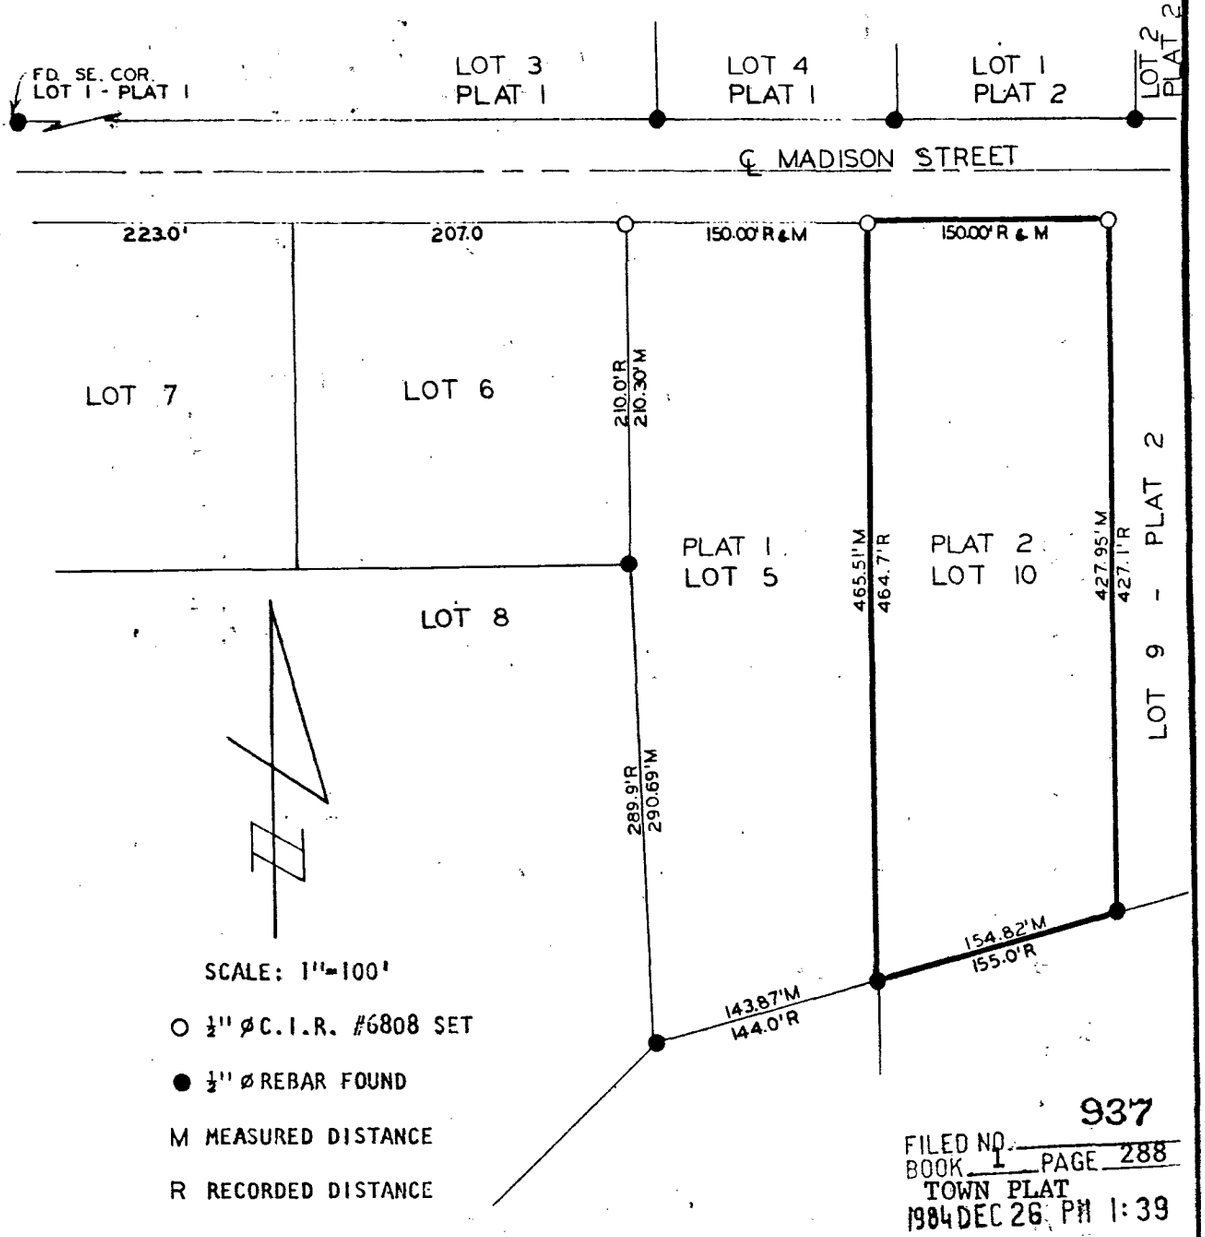

937

FILED NO. _____
BOOK 1 PAGE 288
TOWN PLAT
1984 DEC 26 PM 1:39

MARY E. WELTY
RECORDER
MADISON COUNTY, IOWA
Fee $5.00

I hereby certify that this land surveying document was prepared and the related survey was performed by me or under my direct personal supervision and that I am a duly licensed Land Surveyor under the laws of the State of Iowa.

Signed Jon M. Hochstetler
Jon M. Hochstetler P.E. L.S.

Date 11/21 1984

VANCE & HOCHSTETLER, P.C.
CONSULTING ENGINEERS
WINTERSET, IOWA 50273