
PLAT OF A SURVEY MADE FOR HOLT PLUMBING & HEATING
OF LOT 5, PLAT NO. 1, HELEN MC CALL HUNTOON ADDITION TO
WINTERSET, MADISON COUNTY, IOWA

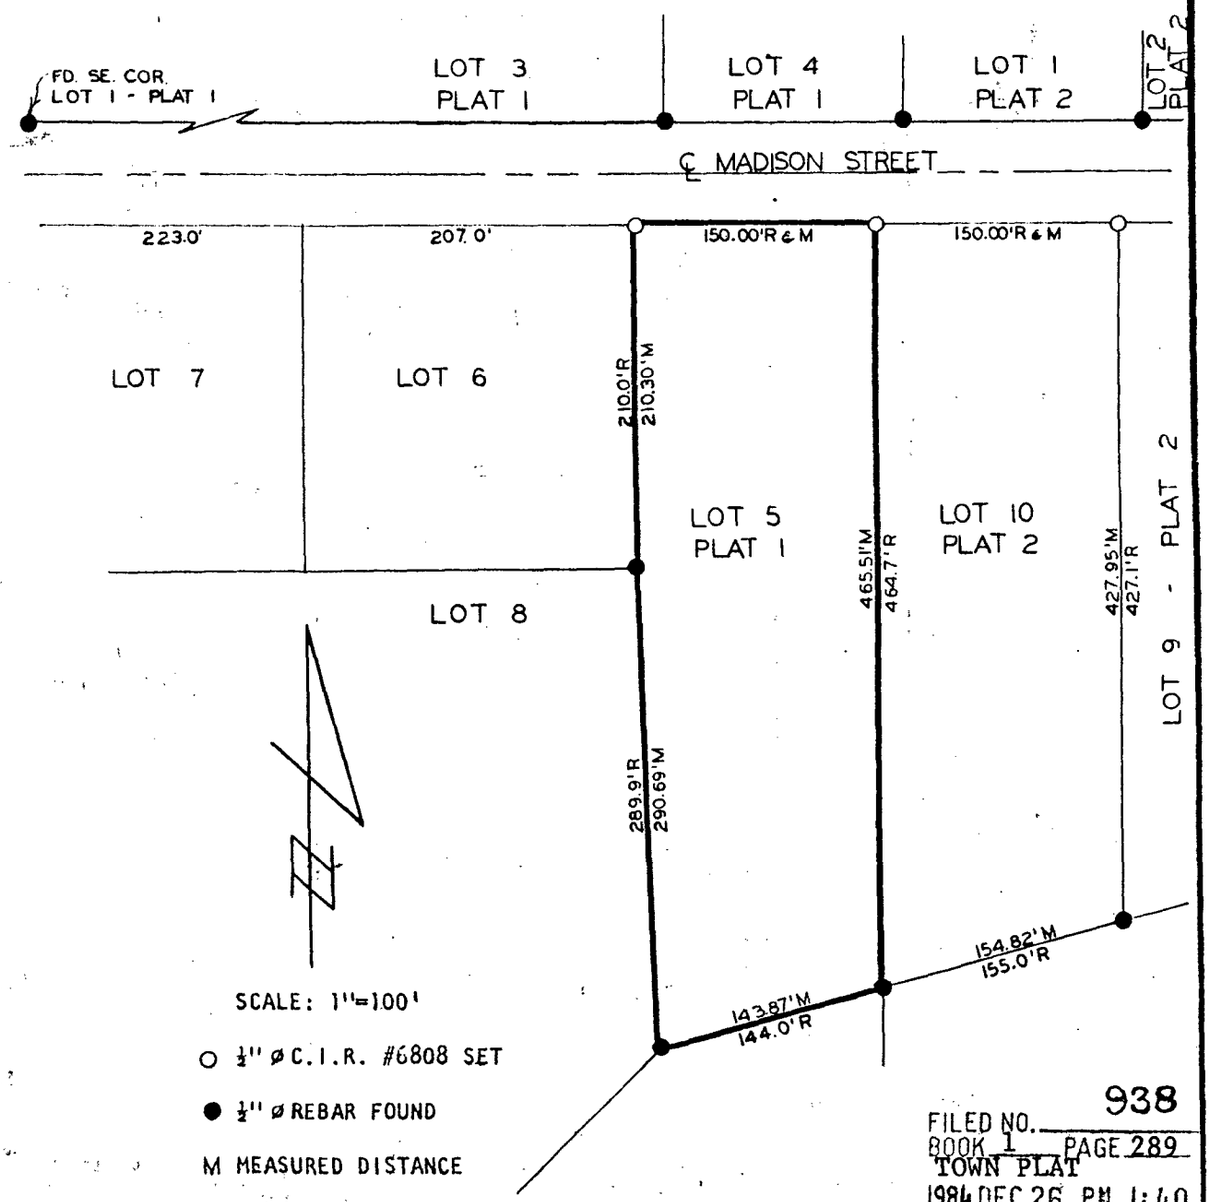


938

FILED NO. _____
BOOK 1 PAGE 289
TOWN PLAT
1984 DEC 26 PM 1:40

MARY E. WELTY
RECORDER
MADISON COUNTY, IOWA
Fee $5.00

Signed _____ Date 11/29 19 84
J. M. Hochstetler, P.E., L.S. Iowa Reg. No 6808

VANCE & HOCHSTETLER, P.C.
CONSULTING ENGINEERS
WINTERSET, IOWA 50273