
PLAT OF SURVEY FOR DEAN BROOKS AND CHARLES HOMMER
OF LOTS 3 & 4 AND M STREET, BLOCK 1
THE JOEL ADDITION TO THE TOWN OF ST. CHARLES,
MADISON COUNTY, IOWA

FILED NO. 205
BOOK 1 PAGE 272
TOWN PLAT
1983 JUL 28 PM 2:40

MARY E. WELTY
RECORDER
MADISON COUNTY, IOWA
Fee $3.00

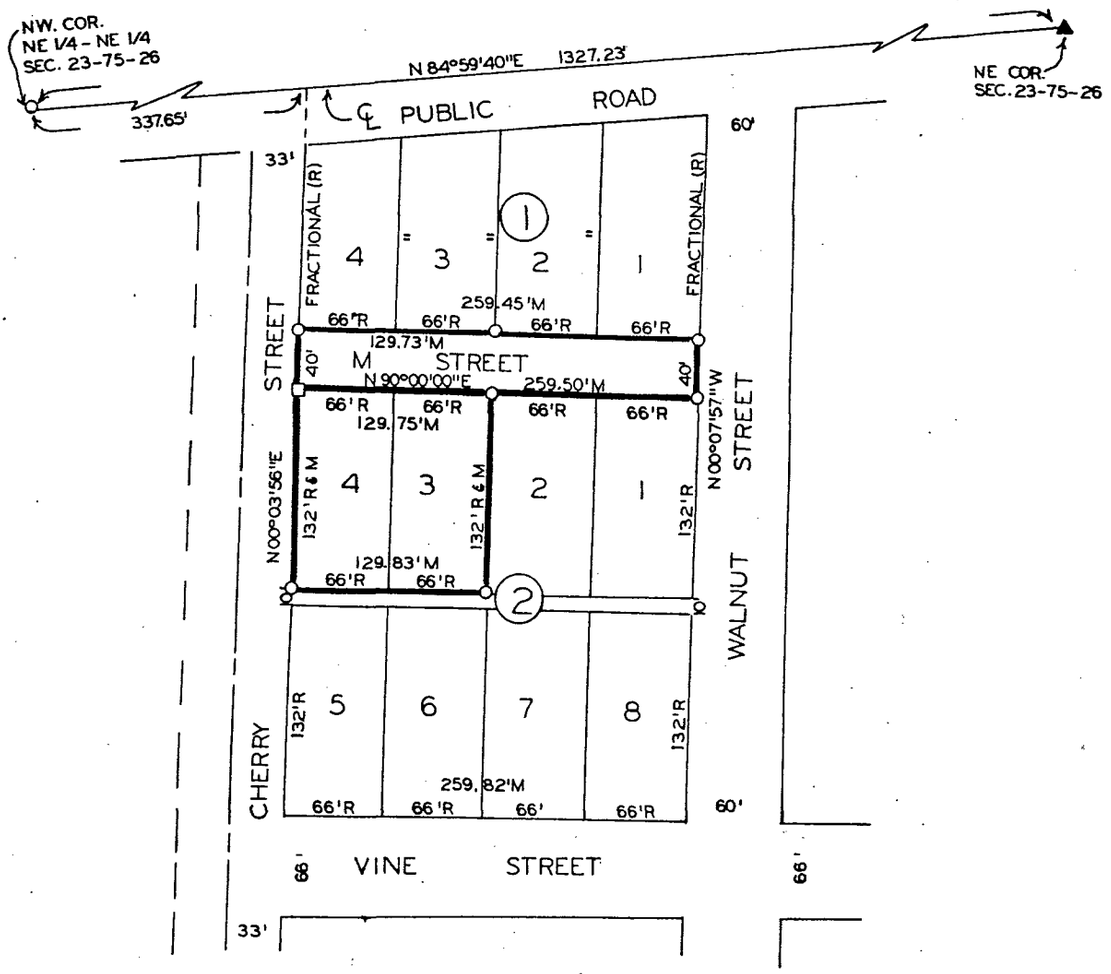

▲ FOUND LEAD PLUG

○ SET C.I.R. #8034

□ CUT AN X

R RECORDED DATA

M MEASURED DATA

SCALE: 1" = 100'

REGISTERED LAND SURVEYOR
REGISTERED
8034
CLEO E.
McCALL
IOWA

I hereby certify that this plat, map, survey or report was made by me or under my direct personal supervision and that I am a duly registered Land Surveyor under the laws of the State of Iowa.

Signed Cleo E. McCall Date 5-19 1983

CLEO E. McCALL, R.L.S. IOWA REG. NO. 8034

VANCE & HOCHSTETLER, P.C.
CONSULTING ENGINEERS
WINTERSET, IOWA 50273