
PLAT OF SURVEY FOR DEANE HOSKINS OF LOT 3 AND ALLEY ABUTTING LOT 3 ON THE EAST, IN BLOCK 9, HARTMAN & YOUNG'S ADDITION TO THE TOWN OF ST. CHARLES, MADISON COUNTY, IOWA

FILED NO. 206
BOOK 1 PAGE 273
TOWN PLAT
1983 JUL 28 PM 2:41

MARY E. WELTY
RECORDER
MADISON COUNTY, IOWA
Fee $3.00

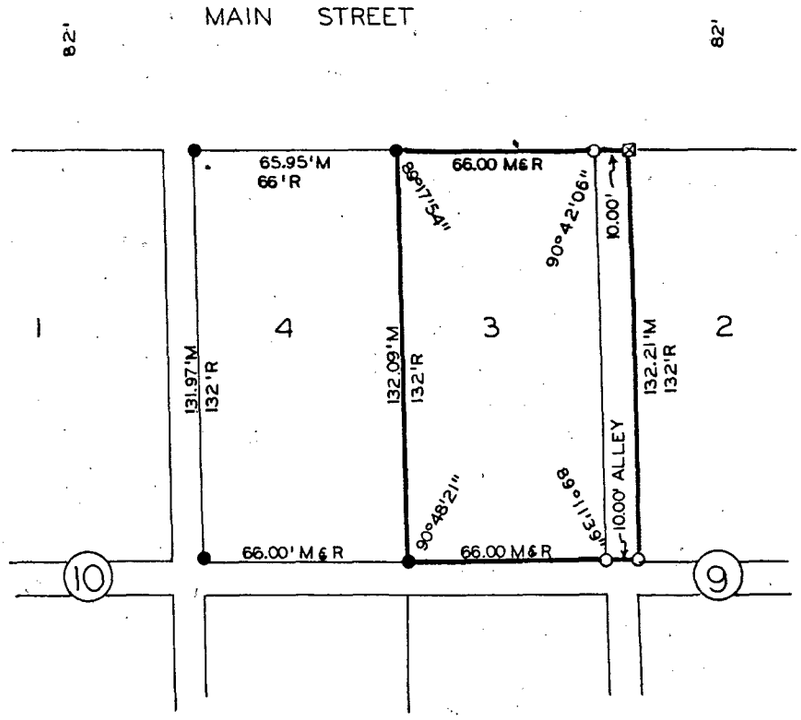

● FOUND C.I.R. #3754

⊠ CUT AN X

○ SET C.I.R. #8034

R RECORDED DISTANCE

M MEASURED DISTANCE

SCALE: 1" = 50'

REGISTERED LAND SURVEYOR
REGISTERED
8034
CLEO E.
McCALL
IOWA

I hereby certify that this plat, map, survey or report was made by me or under my direct personal supervision and that I am a duly registered Land Surveyor under the laws of the State of Iowa.

Signed Cleo E. McCall Date 5-18 19 83

CLEO E. McCALL, R.L.S. IOWA REG. NO. 8034

VANCE & HOCHSTETLER, P.C.
CONSULTING ENGINEERS
WINTERSET, IOWA 50273