
275

DED ✓
REC. ✓
PAGE

PLAT OF A SURVEY FOR MILTON YOUNG OF LOTS 7 AND 8
IN BLOCK 2 OF STOFFER'S ADDITION TO ST. CHARLES,
MADISON COUNTY, IOWA

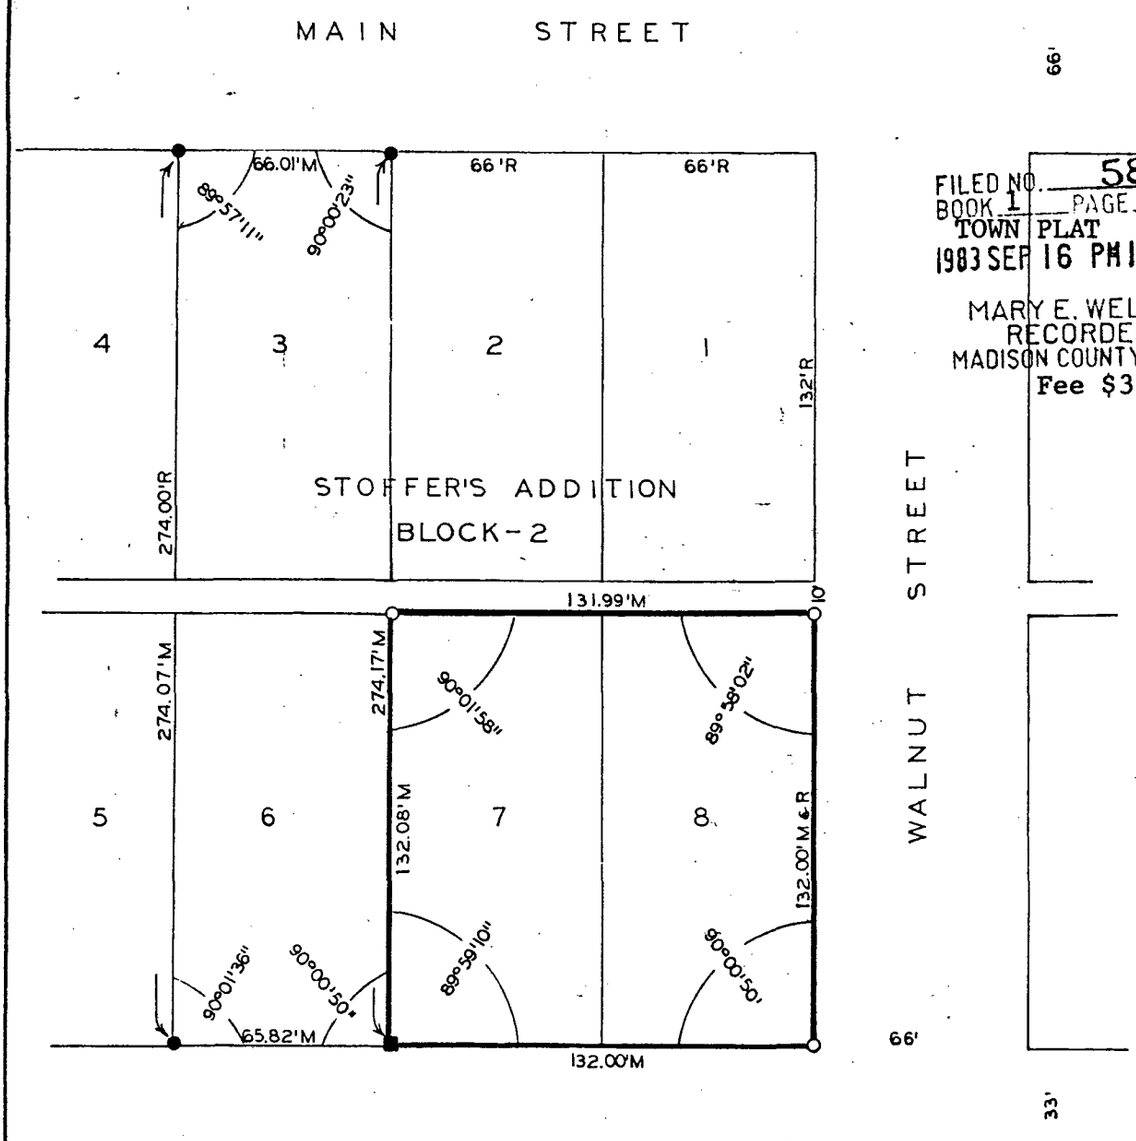

FILED NO. 588
BOOK 1 PAGE 275
TOWN PLAT
1983 SEP 16 PM 12:09

MARY E. WELTY
RECORDER
MADISON COUNTY, IOWA
Fee $3.00



○ SET C.I.R. #8034
● FOUND ½" IRON PIN
■ FOUND ½" PIPE
R RECORD DATA
M MEASURED DATA

REGISTERED LAND SURVEYOR
REGISTERED
8034
CLEO E.
McCALL
IOWA

SCALE: 1" = 50'

I hereby certify that this plat, map, survey or report was made by me or under my direct personal supervision and that I am a duly registered Land Surveyor under the laws of the State of Iowa.

Signed Cleo E. McCall Date 8-25 19 83

CLEO E. McCALL, R.L.S. IOWA REG. NO. 8034

VANCE & HOCHSTETLER, P.C.
CONSULTING ENGINEERS
WINTERSET, IOWA 50273