
IND 1
SEC
PAGE 1

276

PLAT OF SURVEY FOR TERRY HOUSMAN
OF LOT 10 AND THE WEST HALF OF LOT 11,
BLOCK 2, DANFORTH'S 2ND ADDITION TO
WINTERSET, IOWA

FILED NO. 589
BOOK 1 PAGE 276
TOWN PLAT
1983 SEP 16 PM 12:10

MARY E. WELTY
RECORDER
MADISON COUNTY, IOWA
Fee $3.00

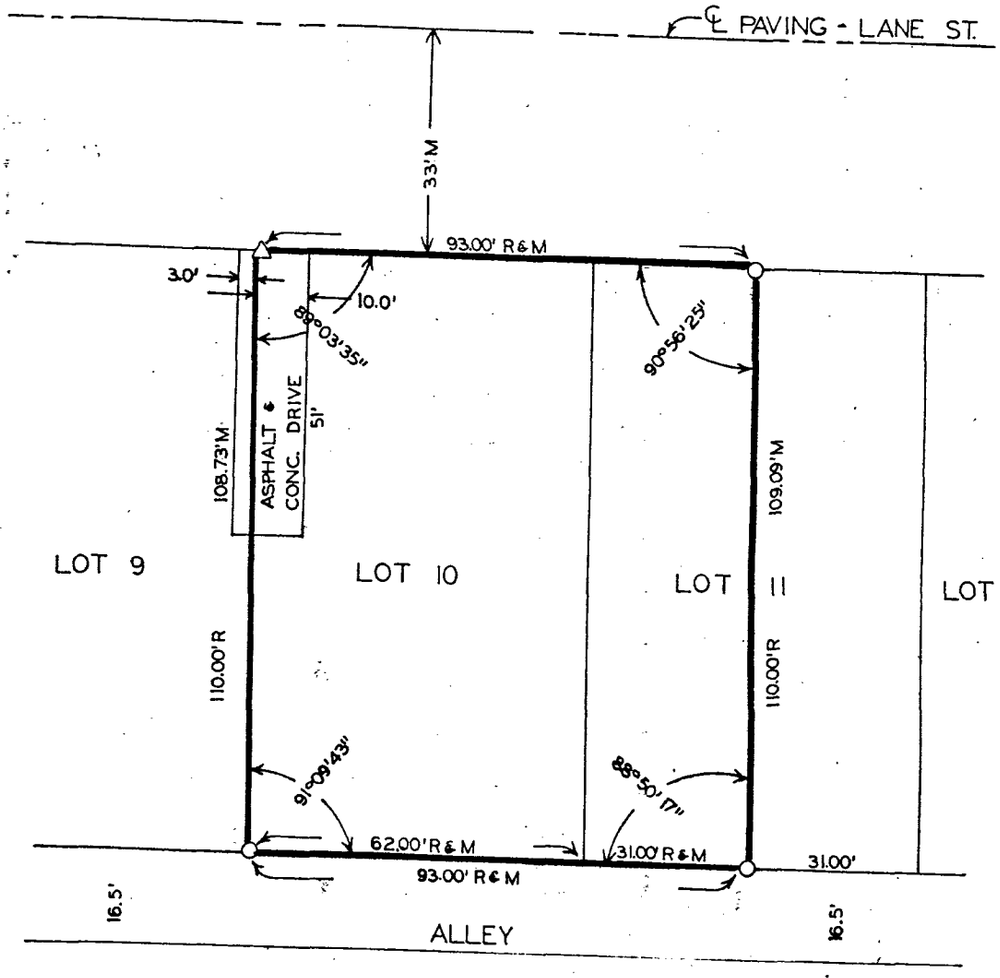

O SET C.I.R. #8034

△ SET P.K. NAIL IN BRASS TAG #8034

R RECORDED DISTANCE

M MEASURED DISTANCE

SCALE: 1" = 30'

REGISTERED LAND SURVEYOR
REGISTERED
8034
CLEO E.
McCALL
IOWA

I hereby certify that this plat, map, survey or report was made by me or under my direct personal supervision and that I am a duly registered Land Surveyor under the laws of the State of Iowa.

Signed Cleo E. McCall Date 7-26 19 83

CLEO E. McCALL, R.L.S. IOWA REG. NO. 8034

VANCE & HOCHSTETLER, P.C.
CONSULTING ENGINEERS
WINTERSET, IOWA 50273