
PLAT OF SURVEY FOR PAULINE MEASE OF LOT 7, LIKEN'S ADDITION TO THE TOWN OF TRURO, MADISON COUNTY, IOWA

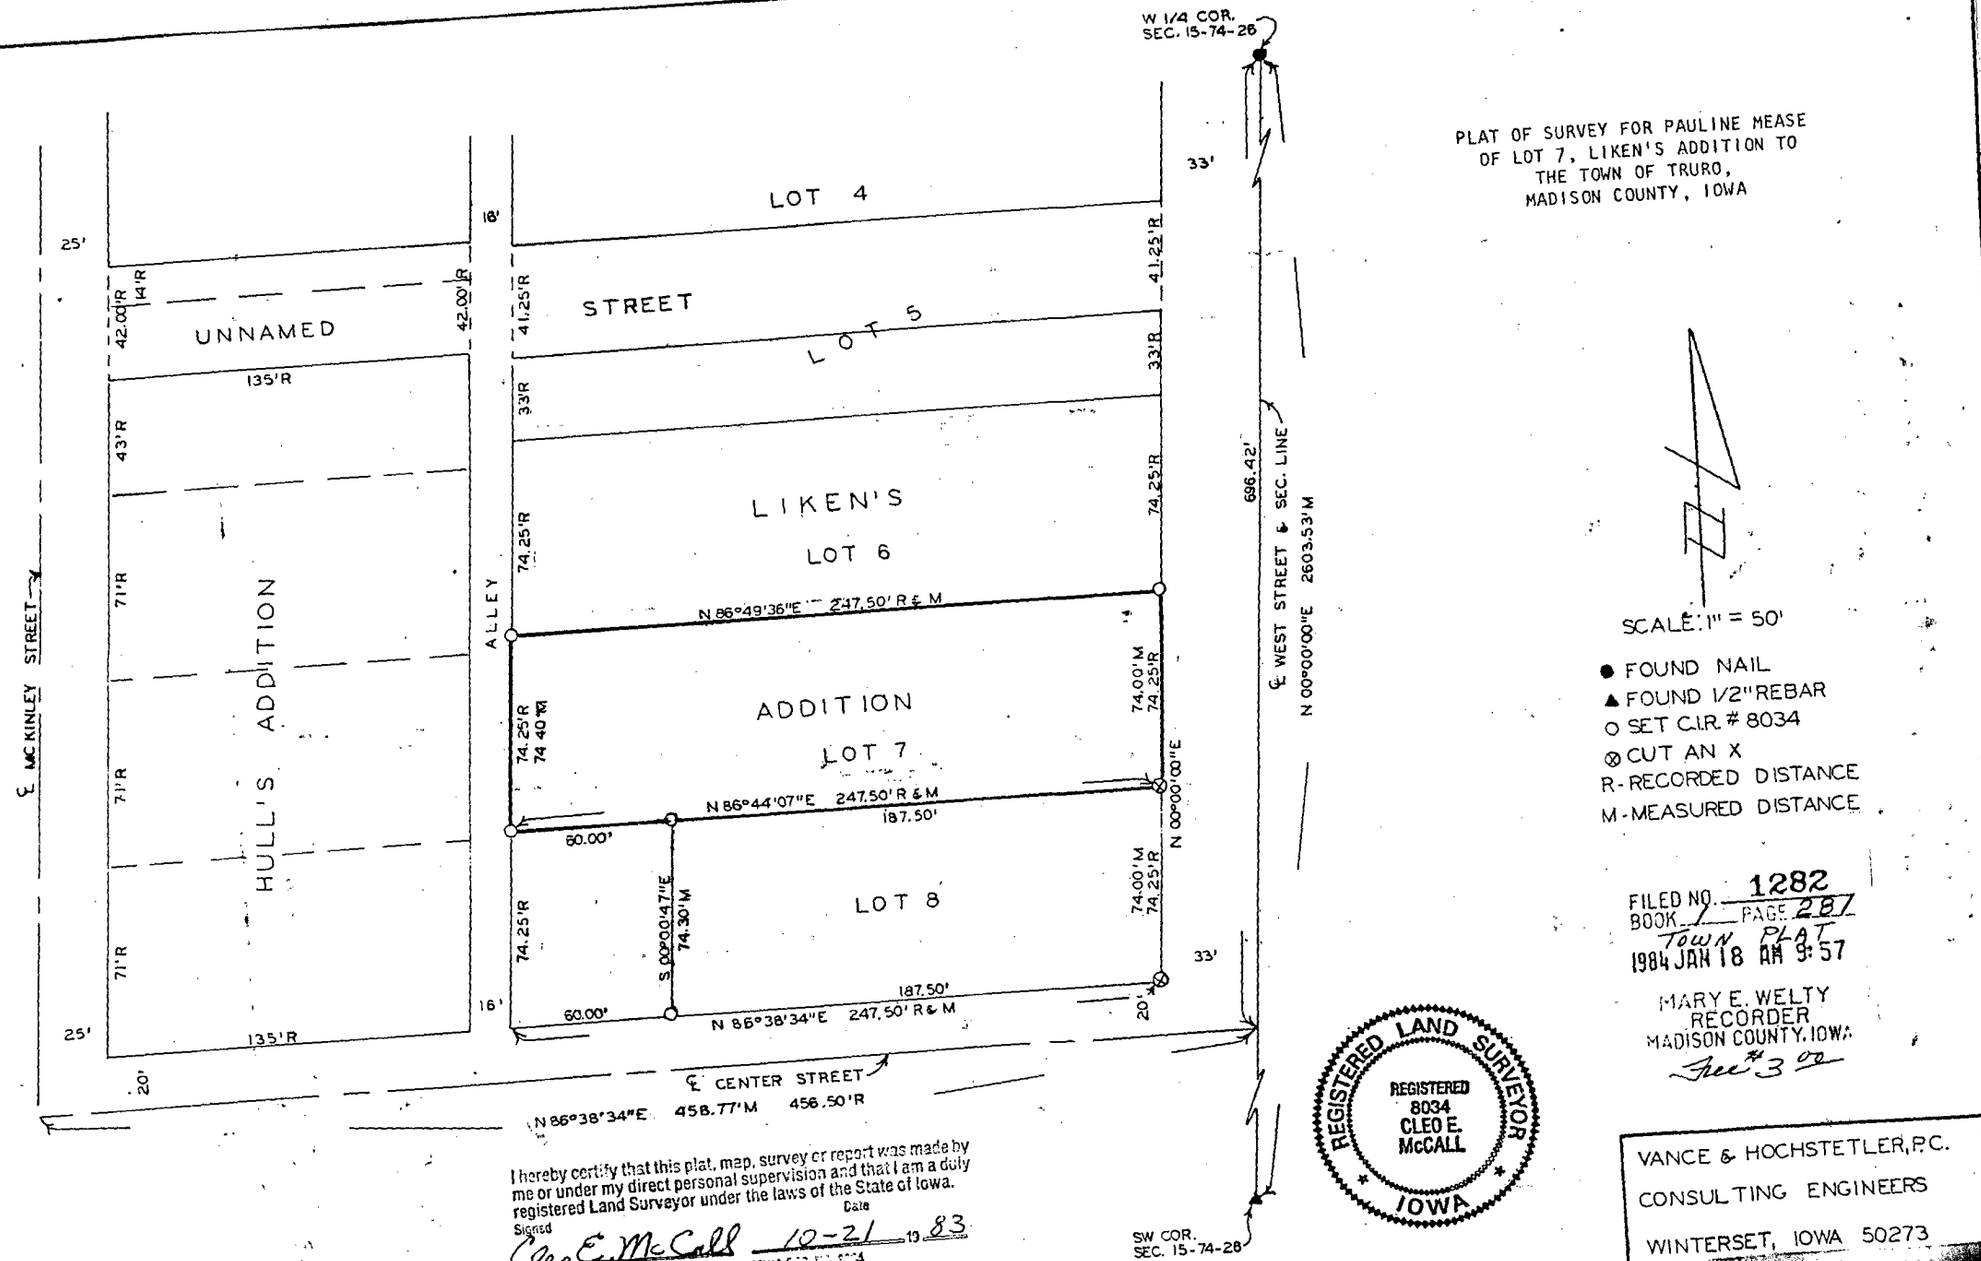

I hereby certify that this plat, map, survey or report was made by me or under my direct personal supervision and that I am a duly registered Land Surveyor under the laws of the State of Iowa.

Signed Cleo E. McCall Date 10-21 19 83

CLEO E. McCALL, P.L.S. IOWA REG. NO. 8034

REGISTERED LAND SURVEYOR
REGISTERED
8034
CLEO E.
McCALL
IOWA

FILED NO. 1282
BOOK 1 PAGE 287
Town PLAT
1984 JAN 18 AM 9:57

MARY E. WELTY
RECORDER
MADISON COUNTY, IOWA
Fee #3.00

VANCE & HOCHSTETLER, P.C.
CONSULTING ENGINEERS
WINTERSET, IOWA 50273

281