
PLAT OF SURVEY FOR BOB DUFF
OF LOTS 7 & 8, BLOCK 13,
JONE'S ADDITION TO WINTERSET, IOWA

FILED NO. 2109
BOOK 1 PAGE 282
Town Plat
1984 MAY 23 PM 3:07
MARY E. WELTY
RECORDER
MADISON COUNTY, IOWA

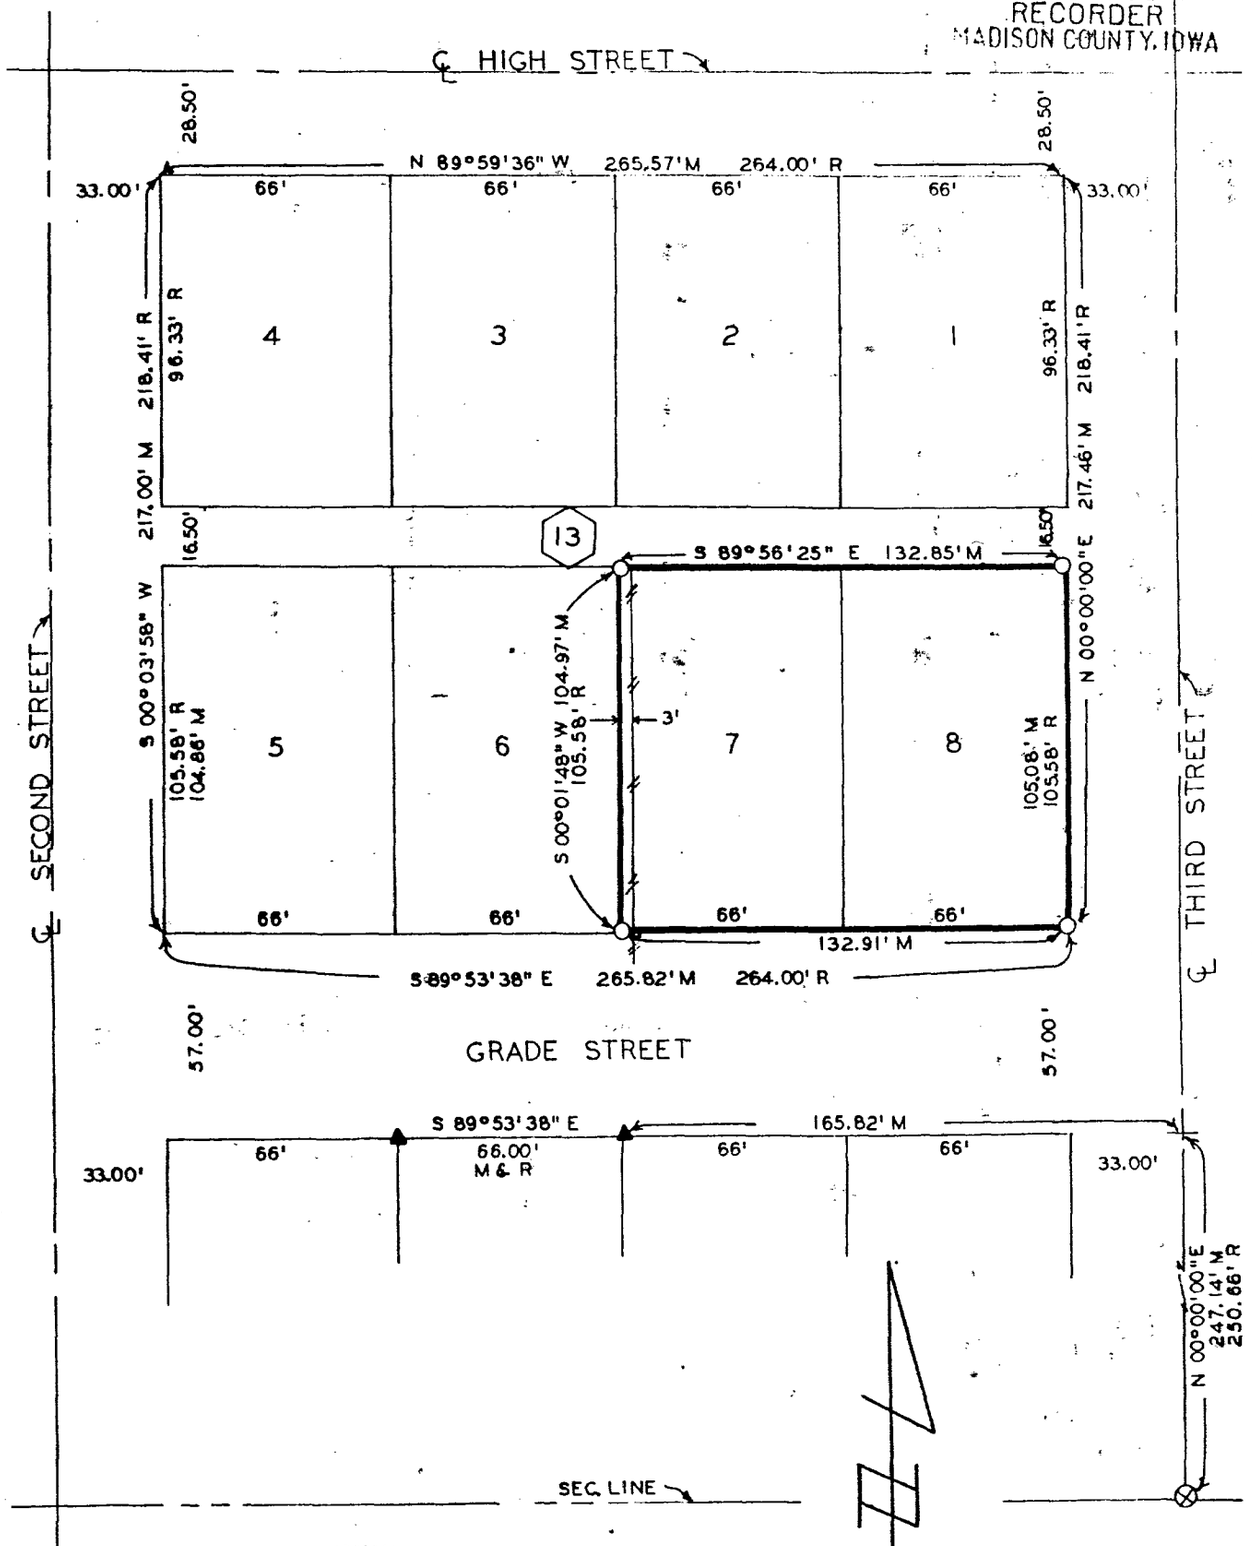

SCALE: 1" = 50'

▲ FOUND C.I.R. #7044

⊗ FOUND CUT X

○ SET C.I.R. #8034

REGISTERED LAND SURVEYOR
REGISTERED
8034
CLEO E.
McCALL
IOWA

I hereby certify that this plat, map, survey or report was made by me or under my direct personal supervision and that I am a duly registered Land Surveyor under the laws of the State of Iowa.

Signed Cleo E. McCall Date 5-14 1984

CLEO E. McCALL, R.L.S. IOWA REG. NO. 8034

VANCE & HOCHSTETLER, P.C.
CONSULTING ENGINEERS
WINTERSET, IOWA 50273