WINTERSET


MADISON COUNTY

IOWA

Exhibit "A" FILED NO. 621 & 622
BOOK 1 PAGE 219
1970 MAY 11 PM 2:50
$2.51
MARY E. WELTY
RECORDER
MADISON COUNTY, IOWA


CITY BUSINESS

OFFICIAL ZONING MAP of the City of Winterset, Iowa, referred to in Ordinance No. 138 of said City adopted June 14, 1960.

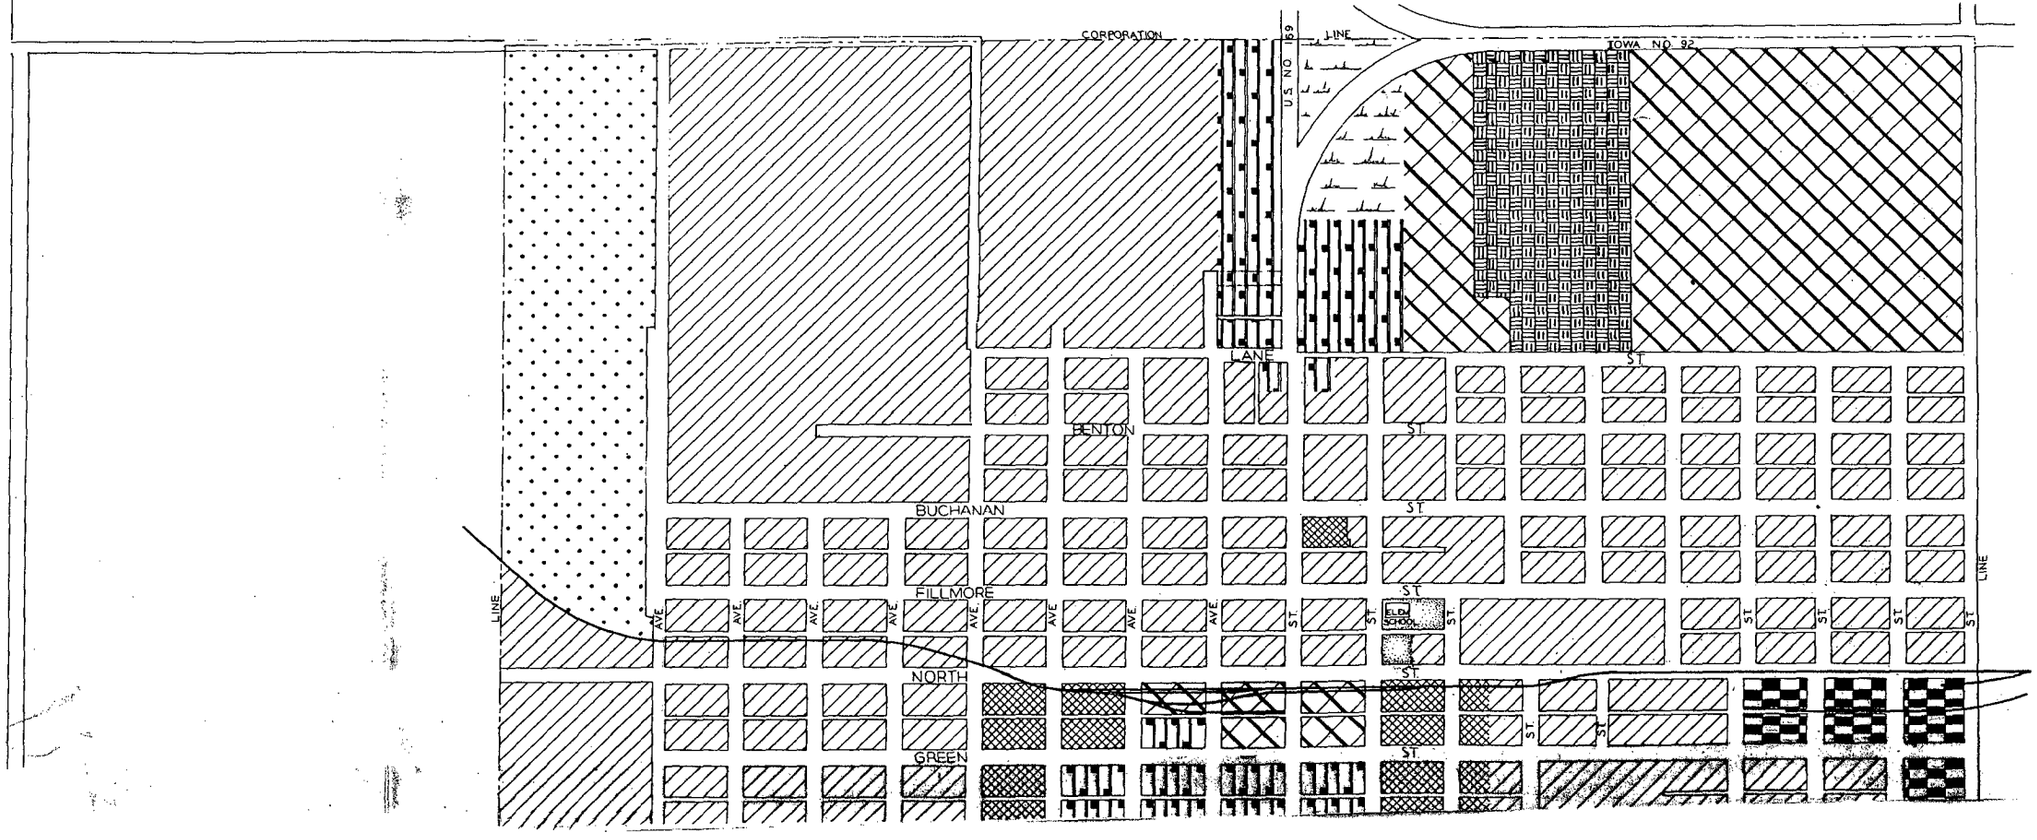

219

Ord. Ordinance No. 202 adopted Jan 3, 1964
Ord. Ordinance No. 203 adopted Feb 3, 1964

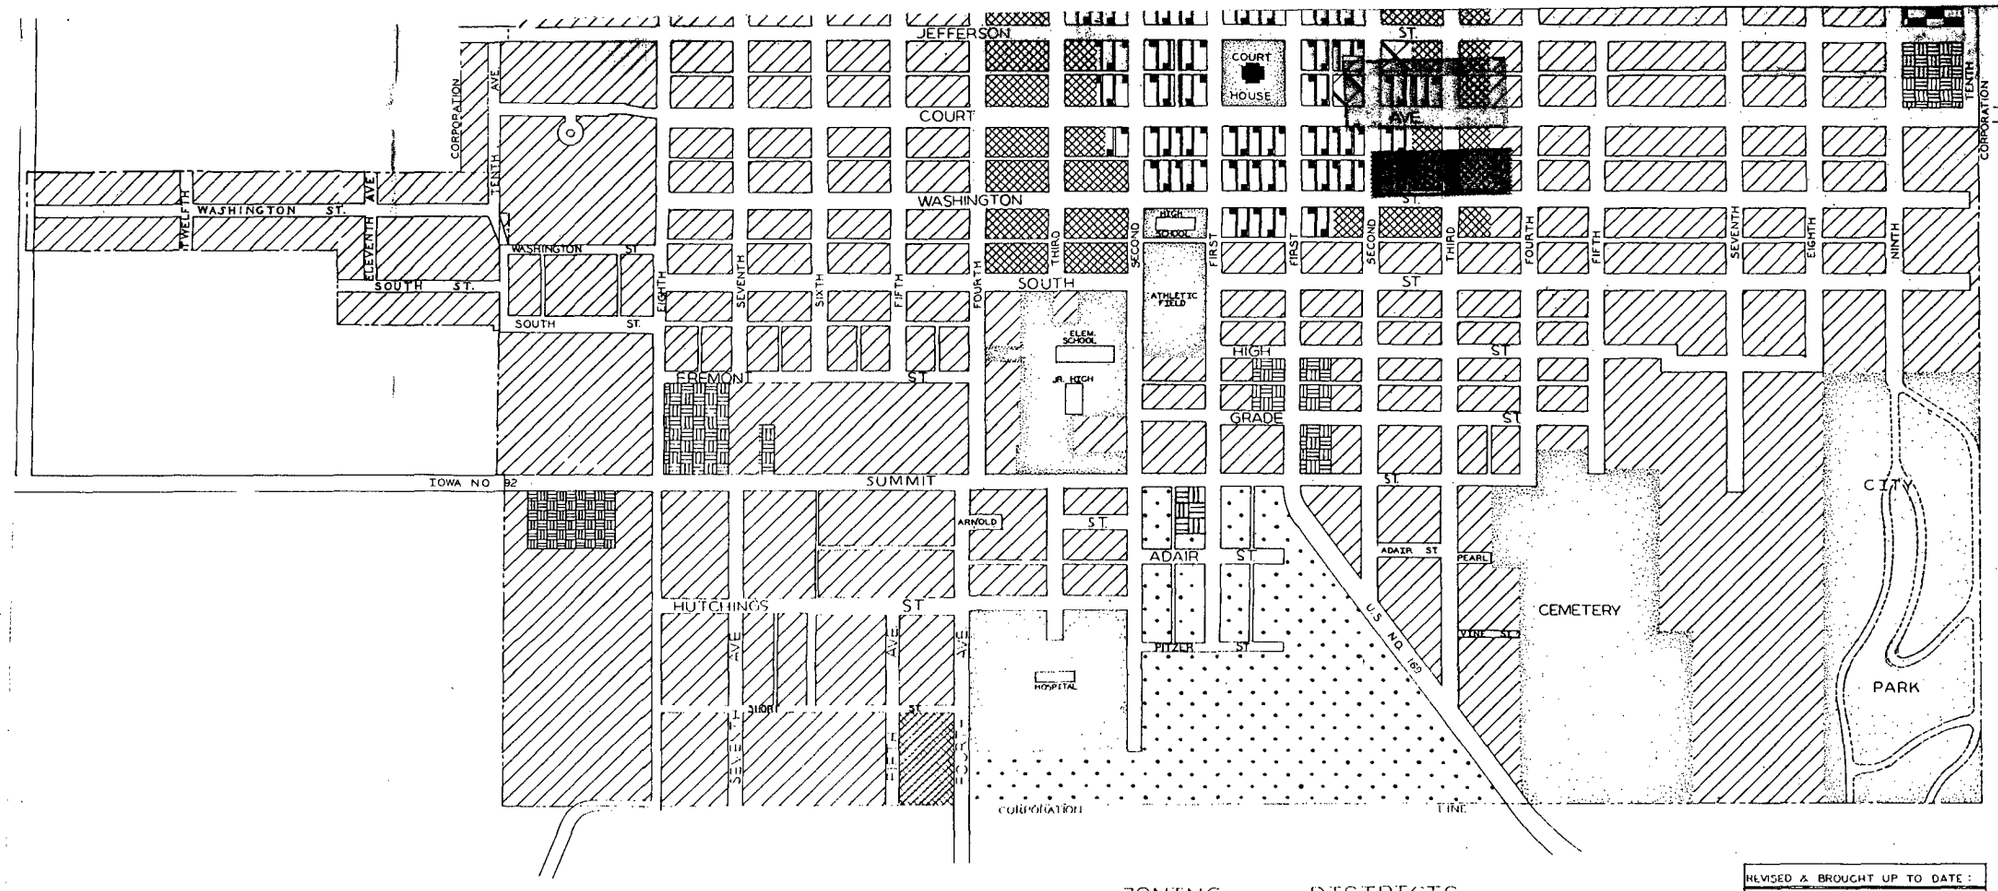

OFFICIAL ZONING MAP
ORDINANCE NUMBER 138
JUNE 14, 1960

NORTH

ZONING DISTRICTS

"A" AGRICULTURE	
"R 1" SINGLE FAMILY	
"R 2" ONE & TWO FAMILY	
"R 3" MULTIPLE FAMILY	
"C 1" LIMITED COMMERCIAL	
"C 2" COMMERCIAL	
"M 1" LIGHT INDUSTRY	
"M 2" HEAVY INDUSTRY	

REVISED & BROUGHT UP TO DATE:
March 20, 1970