
Plat of Survey made for Bertha Clopton, Winterset, Madison County, Iowa.

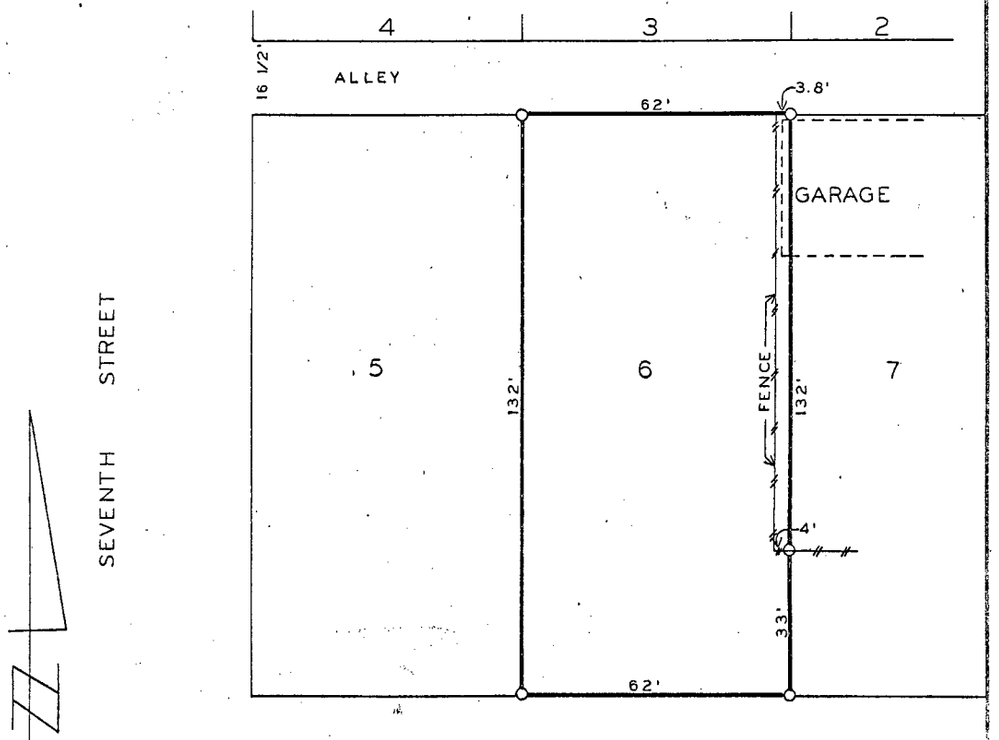

SCALE: 1"=30'

PINS SET

DATE OF SURVEY: November 6, 1973

FILMORE STREET

66.0'

FILED NO. 2024
BOOK 1 PAGE 223
1973 DEC 26 AM 8:27
MARY E WELTY
RECORDER
MADISON COUNTY, IOWA
Fee $2.50

DESCRIPTION:

Lot 6 of Block 3 of Railroad Addition to Winterset, Madison County, Iowa.

I hereby certify that this plan, specification, plat, map, survey or report was made by me or under my direct personal supervision and that I am a duly registered Professional Engineer and Land Surveyor under the laws of the State of Iowa.

Signed J. M. Hochstetler Date Nov. 9 1973

J. M. HOCHSTETLER, P. E., L.S. Iowa Reg. No. 6808

VANCE & HOCHSTETLER
CONSULTING ENGINEERS
WINTERSET, IOWA