
Plat of a Survey made for Pat Corkrean in the South Half ($S\frac{1}{2}$) of the North Half ($N\frac{1}{2}$) of the Southwest Quarter ($SW\frac{1}{4}$) of the Northeast Quarter ($NE\frac{1}{4}$) of Section 36, Township 76 North, Range 28 West of the 5th P.M., Madison County, Iowa.

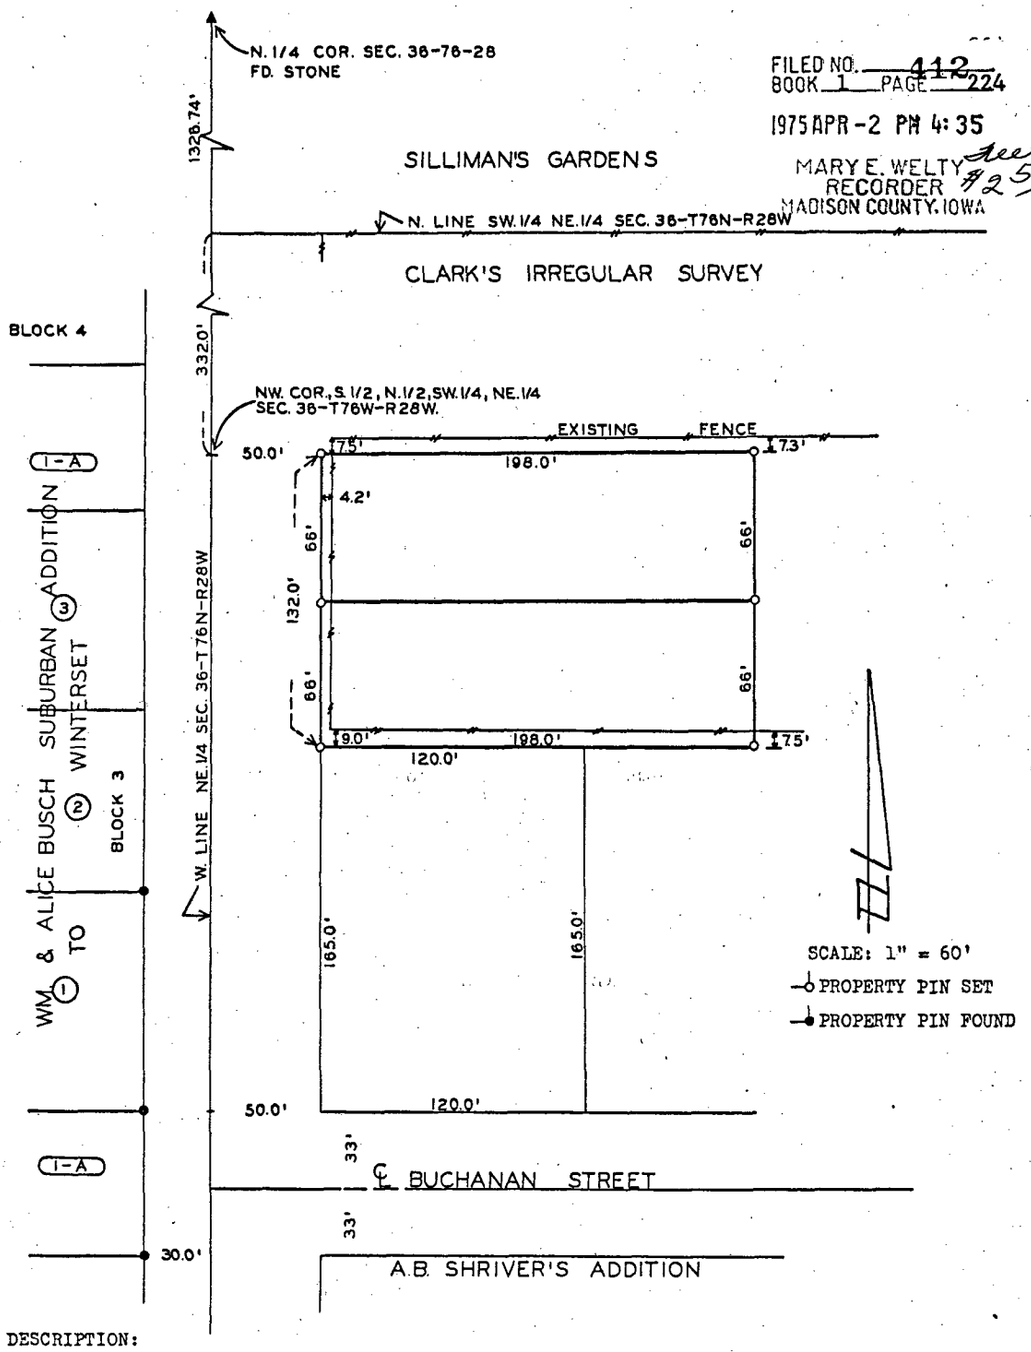

FILED NO. 412
BOOK 1 PAGE 224
1975 APR -2 PM 4:35
MARY E. WELTY
RECORDER
MADISON COUNTY, IOWA
fee #2.50

DESCRIPTION:

Commencing at a point 50 feet east of the Northwest Corner of the South Half ($S\frac{1}{2}$) of the North Half ($N\frac{1}{2}$) of the Southwest Quarter ($SW\frac{1}{4}$) of the Northeast Quarter ($NE\frac{1}{4}$) of Section Thirty-six (36), in Township Seventy-six (76) North, Range Twenty-eight (28) West of the 5th P.M., Madison County, Iowa running thence East 198 feet, thence South 132 feet, thence West 198 feet, thence North 132 feet to the Point of Beginning.

I hereby certify that this plat map, survey or report was under my direct personal supervision and that I am a duly Land Surveyor under the laws of the State of Iowa

Signed J. M. Hochstetler 3/13, 75

J. M. Hochstetler, P.E., L.S. Iowa Reg. No. 6808

VANCE & HOCHSTETLER
CONSULTING ENGINEERS
WINTERSET