
Plat of a Survey made for Richard Pettit of Lot 5 of Block 13½

Pitzer & Knight Addition to City of Winterset, Iowa

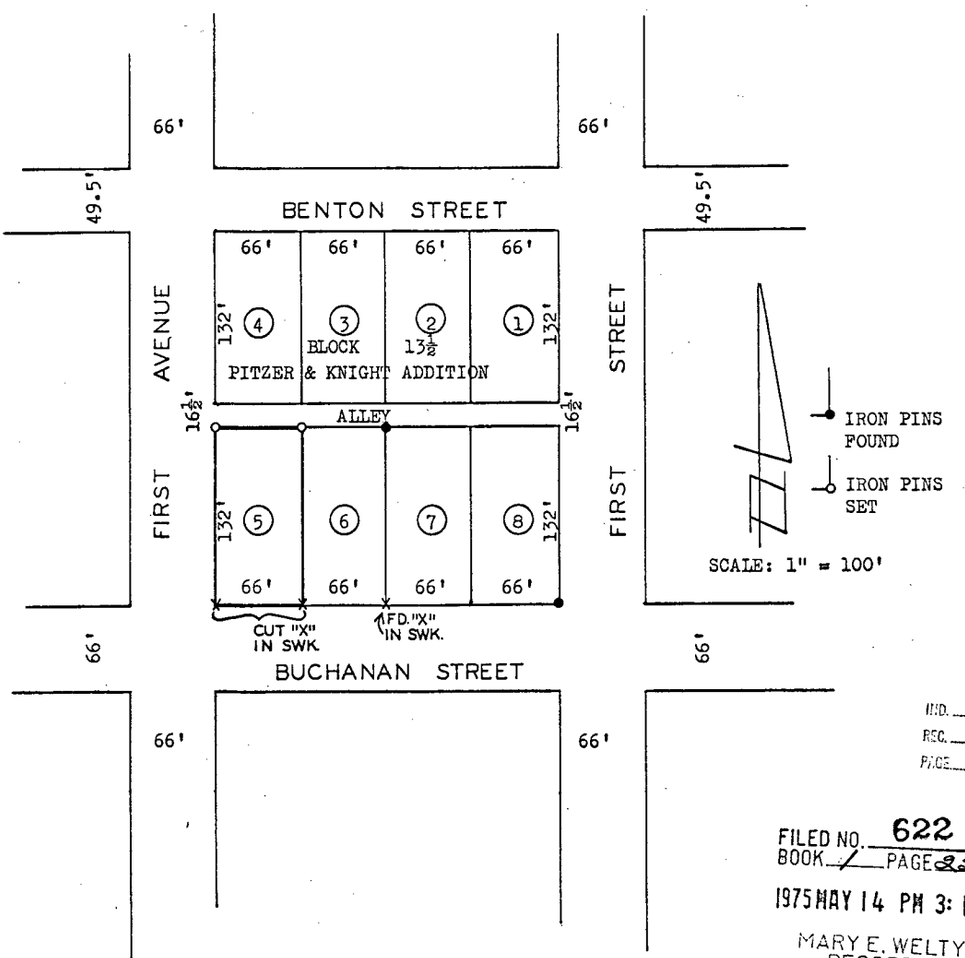

IND. ←
REC. ←
PAGE ←

FILED NO. 622
BOOK 1 PAGE 225
1975 MAY 14 PM 3:10
MARY E. WELTY
RECORDER
MADISON COUNTY, IOWA

I hereby certify that this plat, map, survey or report was made by me or under my direct personal supervision and that I am a duly registered Land Surveyor under the laws of the State of Iowa

Signed J. M. Hochstetler Date May 9 1975

J. M. Hochstetler, P.E. L.S. Iowa Reg. No. 6808

VANCE & HOCHSTETLER
CONSULTING ENGINEERS
WINTERSET, IOWA