Document 2014 497

Book 2014 Page 497 Type 06 026 Pages 1
Date 3/04/2014 Time 3:11 PM
Rec Amt $7.00

INDX ✓
ANNO
SCAN
CHEK

LISA SMITH, COUNTY RECORDER
MADISON COUNTY IOWA

VANCE & HOCHSTETLER, P.C. • CONSULTING ENGINEERS • WINTERSET, IOWA 50273

14-165

CHARLES T. VANCE • 110 WEST GREEN ST., WINTERSET, IOWA • (515) 462-3995
JAMES M. HOCHSTETLER • 110 WEST GREEN ST., WINTERSET, IOWA • FAX: (515) 462-9845

PLAT OF SURVEY OF LOT 1, BLOCK 14, WEST ADDITION TO CITY OF WINTERSET, MADISON COUNTY, IOWA.
OWNED BY DUSTIN E. CRANDALL

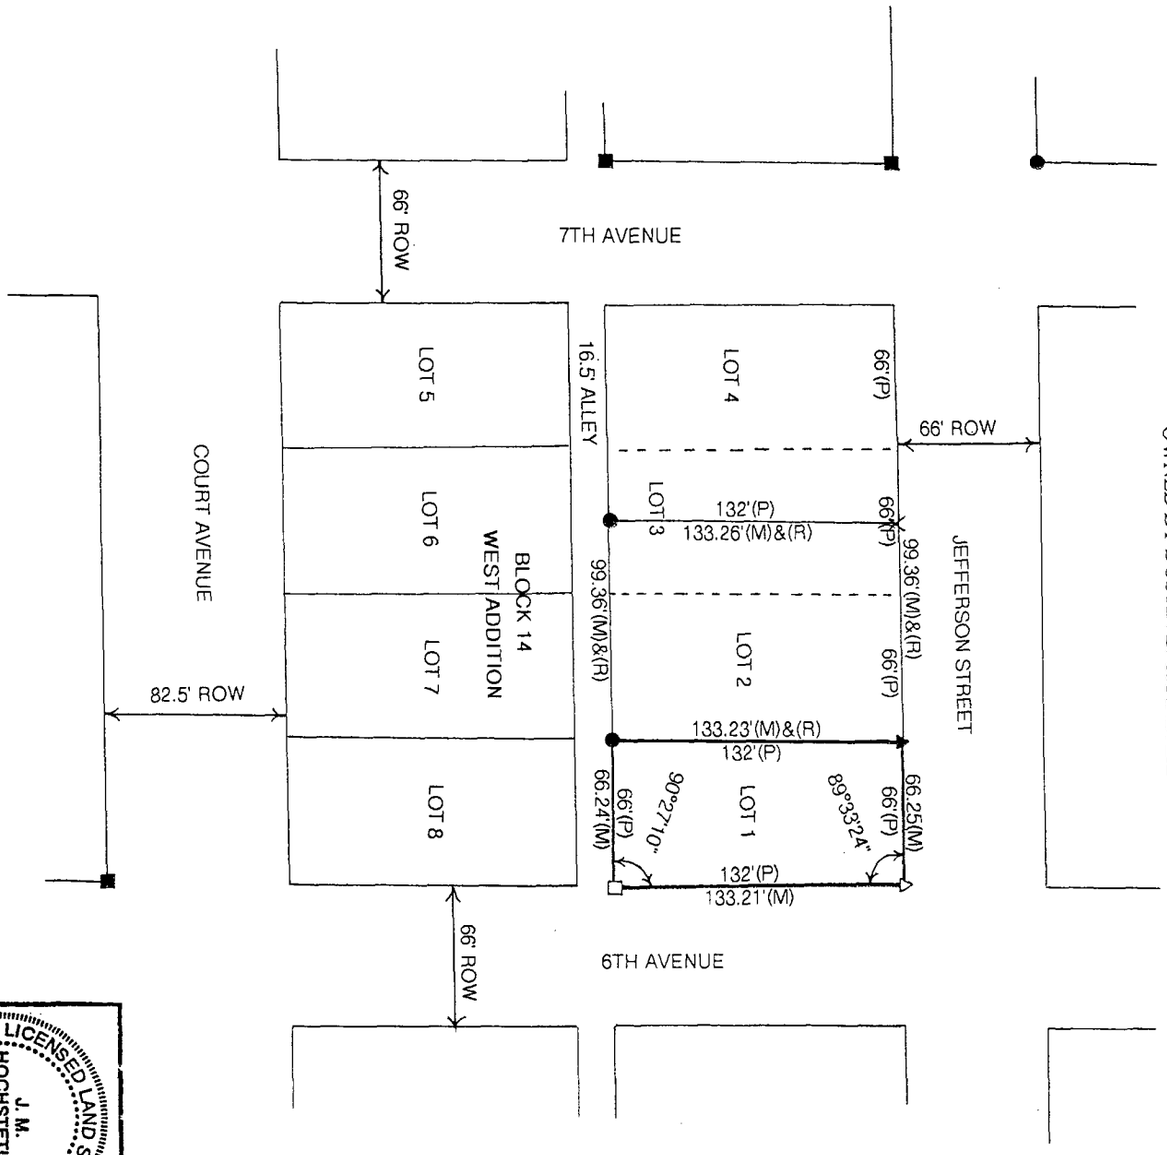

DATE OF SURVEY: 2-12-2014

△ CUT "X" IN SIDEWALK
□ SET R.R. SPIKE
▲ FOUND CUT "X" SIDEWALK
● CAPPED IRON ROD (CIR) #6808 FOUND
■ CIR #5041 FOUND
(M) MEASURED DISTANCE
(P) PLATTED DISTANCE
(R) RECORDED DISTANCE

LICENSED LAND SURVEYOR
J. M. HOCHSTETLER
#6808
IOWA

I hereby certify that this land surveying document was prepared and the related survey work was performed by me or under my direct personal supervision and that I am a duly licensed Land Surveyor under the laws of the State of Iowa.

J.M. Hochstetler 2/17/14
J.M. HOCHSTETLER
License number 6808 Date
My license renewal date is December 31, 2014
Pages or sheets covered by this seal: 1