Document 2014 797

Book 2014 Page 797 Type 06 043 Pages 1
Date 4/07/2014 Time 3:39 PM
Rec Amt $7.00

INDX
ANNO
SCAN

LISA SMITH, COUNTY RECORDER
MADISON COUNTY IOWA

CHEK

VANCE & HOCHSTETLER, P.C. CONSULTING ENGINEERS, WINTERSET, IOWA (515)462-3995

CHARLES T. VANCE, 110 WEST GREEN ST., WINTERSET, IOWA 50273
JAMES M. HOCHSTETLER, 110 WEST GREEN ST., WINTERSET, IOWA 50273

UNITED STATES PUBLIC LAND SURVEY CORNER CERTIFICATE

OF


Land Survey Monuments situated in Section 35, Township 76North, Range 26 West, of the Fifth Principal Meridian, Madison County, Iowa.
Previously recorded in N/A (book, page, document number, etc.) in County Recorder's Office.

(Show reason for preparing this certificate, the evidence and detailed procedures used in establishing the corner positions and monumentation found or placed.)


Monument Description and Remarks: Found all four of the section corners and the East and West Quarter Corners. Calculated the North and South Quarter Corners at the Midpoint between the NE. & NW. Section Corners and the SE. & SW. Section Corners. Quarter-Quarter Corners were calculated at Midpoint between Section Corners and Quarter Corners and some were adjusted to match found Quarter-Quarter Corners

PLAN - VIEW


(Show a minimum of three reference ties to durable physical objects, relevant monuments and physical conditions that will enable recovery of the corner.)

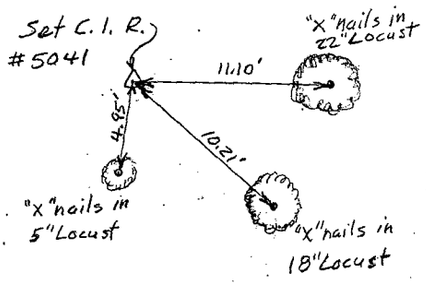


Ref. to NE. Cor. SE.¼-NW.¼ Sec. 35-76-26

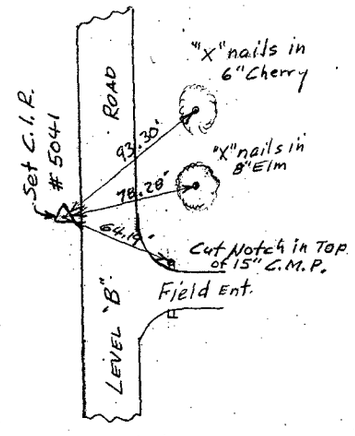


Ref. to NW. Cor. SW.¼-NW.¼ Sec. 35-76-26

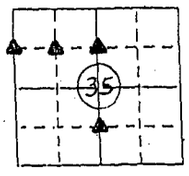

N

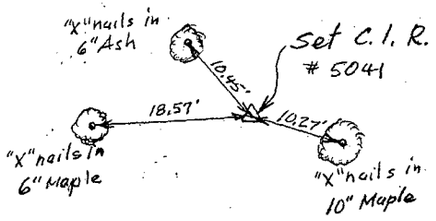

Ref. to SE. Cor., NE.¼-SW.¼ Sec. 35-76-26

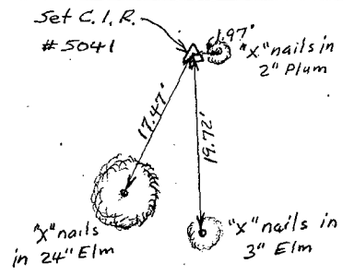

Ref. to NE. Cor. SW.¼-NW.¼ Sec. 35-76-26

PROFESSIONAL ENGINEER LICENSED CHARLES T. VANCE 5041 IOWA LAND SURVEYOR

I hereby certify that this land surveying document was prepared and the related survey work was preformed by me or under my direct personal supervision and that I am a duly licensed Land Surveyor under the laws of the State of Iowa.

Charles T. Vance 3 April 2014
Charles T. Vance, PE & PLS Date

License No. 5041

My License renewal date is 31, December 2015

List Corners to be Indexed

Corners	Section	Twp	Range
NE. COR. SE.¼-NW.¼	35	76	26
SE. Cor. NE.¼-SW.¼	35	76	26
NW. Cor. SW.¼ NW.¼	35	76	26
NE. Cor. SW.¼ NW.¼	35	76	26