Document 2014 1663

Book 2014 Page 1663 Type 06 043 Pages 1
Date 7/11/2014 Time 10:36 AM
Rec Amt $7.00

INDX ✓
ANNO
SCAN

LISA SMITH, COUNTY RECORDER
MADISON COUNTY IOWA

CHEK

VANCE & HOCHSTETLER, P.C. CONSULTING ENGINEERS, WINTERSET, IOWA (515)462-3995
1495 CHARLES T. VANCE, 110 WEST GREEN ST., WINTERSET, IOWA 50273
JAMES M. HOCHSTETLER, 110 WEST GREEN ST., WINTERSET, IOWA 50273

UNITED STATES PUBLIC LAND SURVEY CORNER CERTIFICATE

OF


Land Survey Monuments situated in Section 11, Township 77 NORTH, Range 28 WEST, of the Fifth Principal Meridian, MADISON County, Iowa.
Previously recorded in N/A (book, page, document number, etc.) in County Recorder's Office.

(Show reason for preparing this certificate, the evidence and detailed procedures used in establishing the corner positions and monumentation found or placed.)

Monument Description and Remarks: Set Capped Iron Rod #5041 at the Southwest Corner of the Northwest Quarter of the Southwest Quarter of Section 11, Township 77 North, Range 28 West of the 5th PM; Set Capped Iron Rod on line and Mid-distance between the West Quarter Corner and the Southwest Corner of said Section 11, Township 77 North, Range 28 West of the 5th P.M.

PLAN - VIEW

(Show a minimum of three reference ties to durable physical objects, relevant monuments and physical conditions that will enable recovery of the corner.)

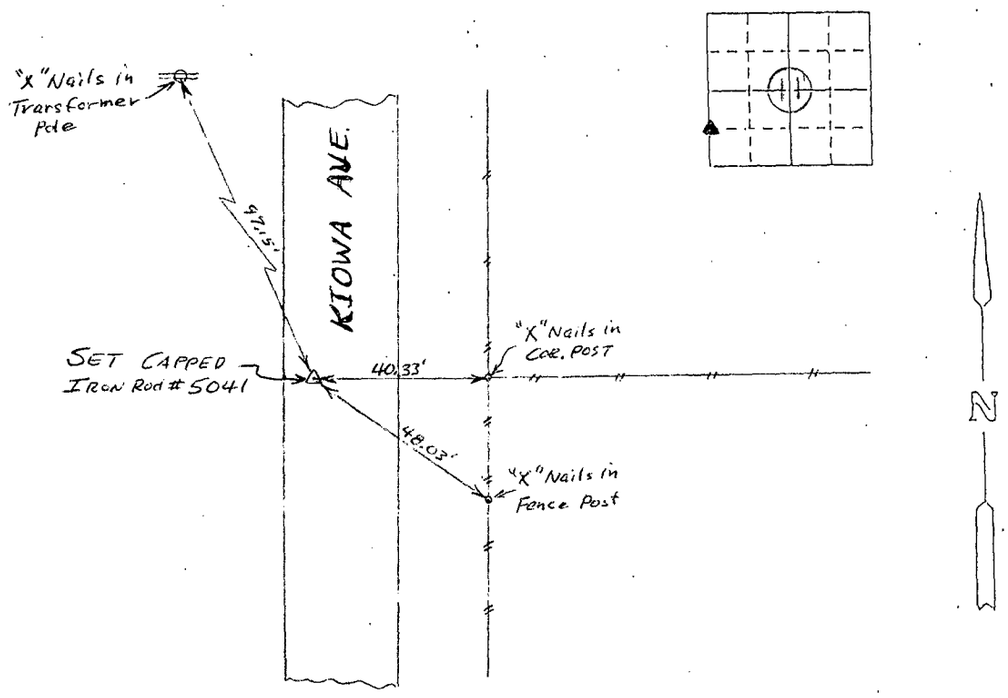

Ref. to SW. COR. OF THE NW. 1/4 OF THE SW. 1/4 OF Section 11, T77N, R28W.

I hereby certify that this land surveying document was prepared and the related survey work was preformed by me or under my direct personal supervision and that I am a duly Licensed Land Surveyor under the laws of the State of Iowa.

Charles T. Vance 3 July 2014
Charles T. Vance, PE & PLS Date

License No. 5041

My License renewal date is 31, December 2015

PROFESSIONAL ENGINEER LICENSED CHARLES T. VANCE 5041 IOWA LAND SURVEYOR

List Corners to be Indexed

Corners	Section	Twp	Range
SW. COR. NW. 1/4 - SW. 1/4	11	77	28