



Document 2014 1762

Book 2014 Page 1762 Type 06 026 Pages 1

Date 7/22/2014 Time 3:01 PM

Rec Amt \$7.00

INDX ✓
ANNO
SCAN
CHEK


LISA SMITH, COUNTY RECORDER
MADISON COUNTY IOWA

VANCE & HOCHSTETLER, P.C. • CONSULTING ENGINEERS • WINTERSET, IOWA 50273

14-1055 CHARLES T. VANCE • 110 WEST GREEN ST., WINTERSET, IOWA • (515) 462-3995

JAMES M. HOCHSTETLER • 110 WEST GREEN ST., WINTERSET, IOWA • FAX: (515) 462-9845

PROPERTY LINE RETRACEMENT SURVEY OF LOT 14, OF HY-VIEW SUBDIVISION IN THE
SOUTHEAST QUARTER OF THE SOUTHWEST QUARTER OF SECTION 10, TOWNSHIP 77
NORTH, RANGE 26 WEST OF THE 5TH P.M., MADISON COUNTY, IOWA
OWNED BY SHARON L. ROSENBERG

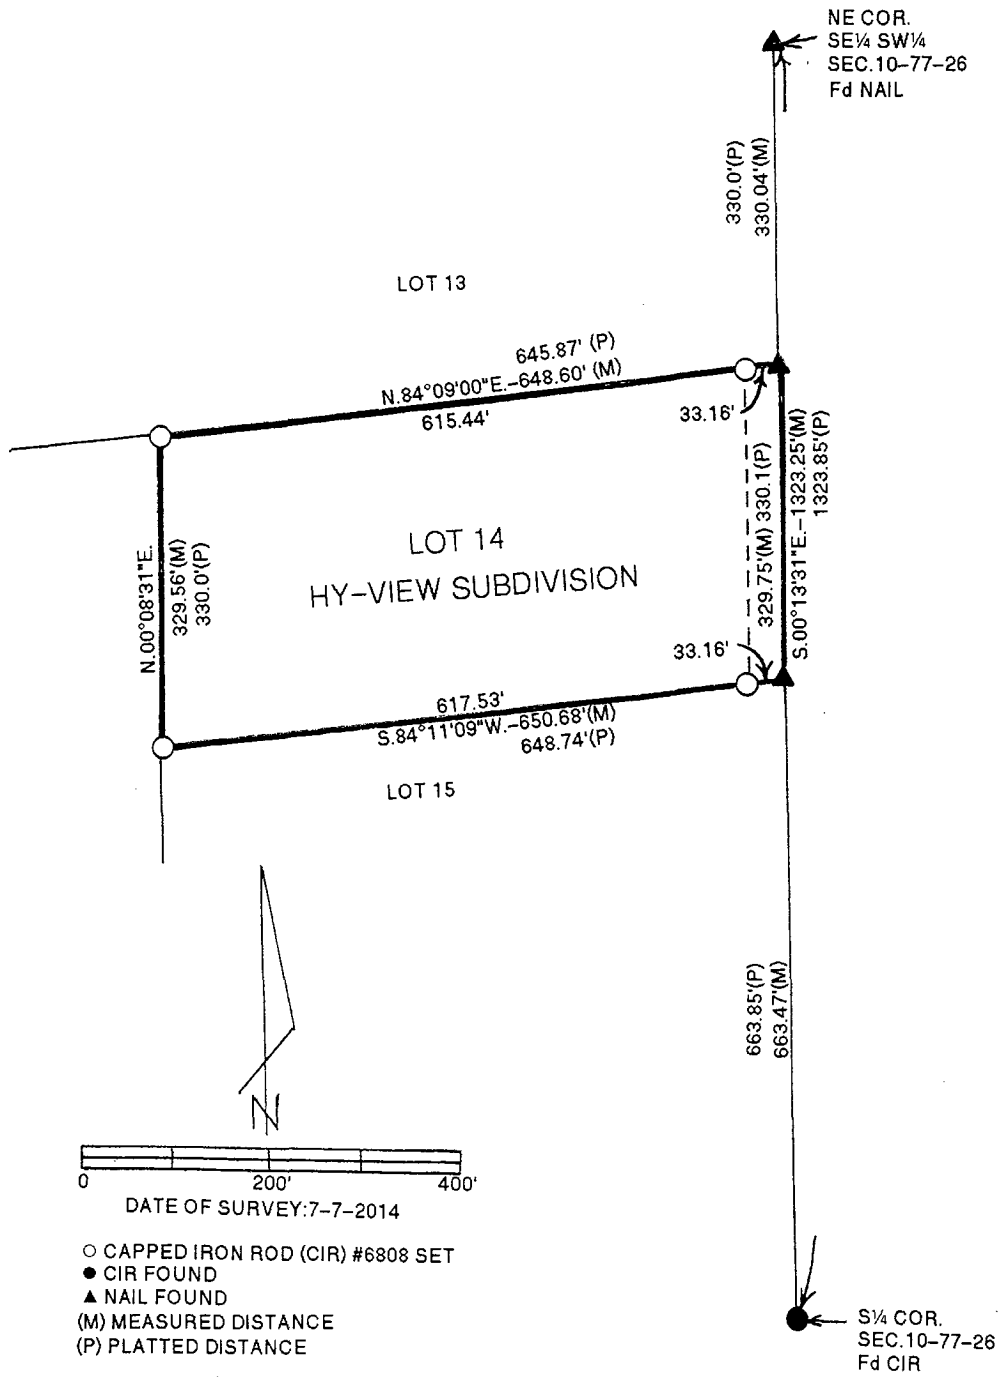

LICENSED LAND SURVEYOR
J. M. HOCHSTETLER
#6808
IOWA

I hereby certify that this land surveying document was prepared and the related surveying work was performed by me or under my direct personal supervision and that I am a duly licensed Land Surveyor under the laws of the State of Iowa.

J. M. Hochstetler
J. M. HOCHSTETLER
License number 6808 Date 7/14/14
My license renewal date is December 31, 2015
Pages or sheets covered by this seal: 1