



Document 2014 1820

Book 2014 Page 1820 Type 06 043 Pages 1  
Date 7/28/2014 Time 12:17 PM  
Rec Amt \$.00

INDX ✓  
ANNO ✓  
SCAN  
CHEK

LISA SMITH, COUNTY RECORDER  
MADISON COUNTY IOWA

Prepared By: Michael James Hackett, Madison County Engineer's Office, 1105 E. Court Ave., Winterset, Ia. 50273, Tel. (515) 462-1136

# UNITED STATES PUBLIC LAND SURVEY CORNER CERTIFICATE OF


Land Survey Monuments situated in Section 16, Township 74 N, Range 26 W, of the Fifth Principal Meridian, Madison County, Iowa.  
Previously recorded in Book 2007, Page 3567 in County Recorder's Office.  
(book, page, document number, etc.)

(Show reason for preparing this certificate, the evidence and detailed procedures used in establishing the corner positions and monumentation found or placed.)

Monument Description and Remarks: Found P-K Nail. The existing tie information was checked before Madison County highway maintenance project FM-CO61(93)--55-61 A.C.C. pavement resurfacing and reconstruction. Accepted position. The reason for preparing this certificate is because the existing ties distances varied from previously recorded.


## PLAN VIEW

(Show a minimum of three reference ties to durable physical objects, relevant monuments and physical conditions that will enable recovery of the corner.)

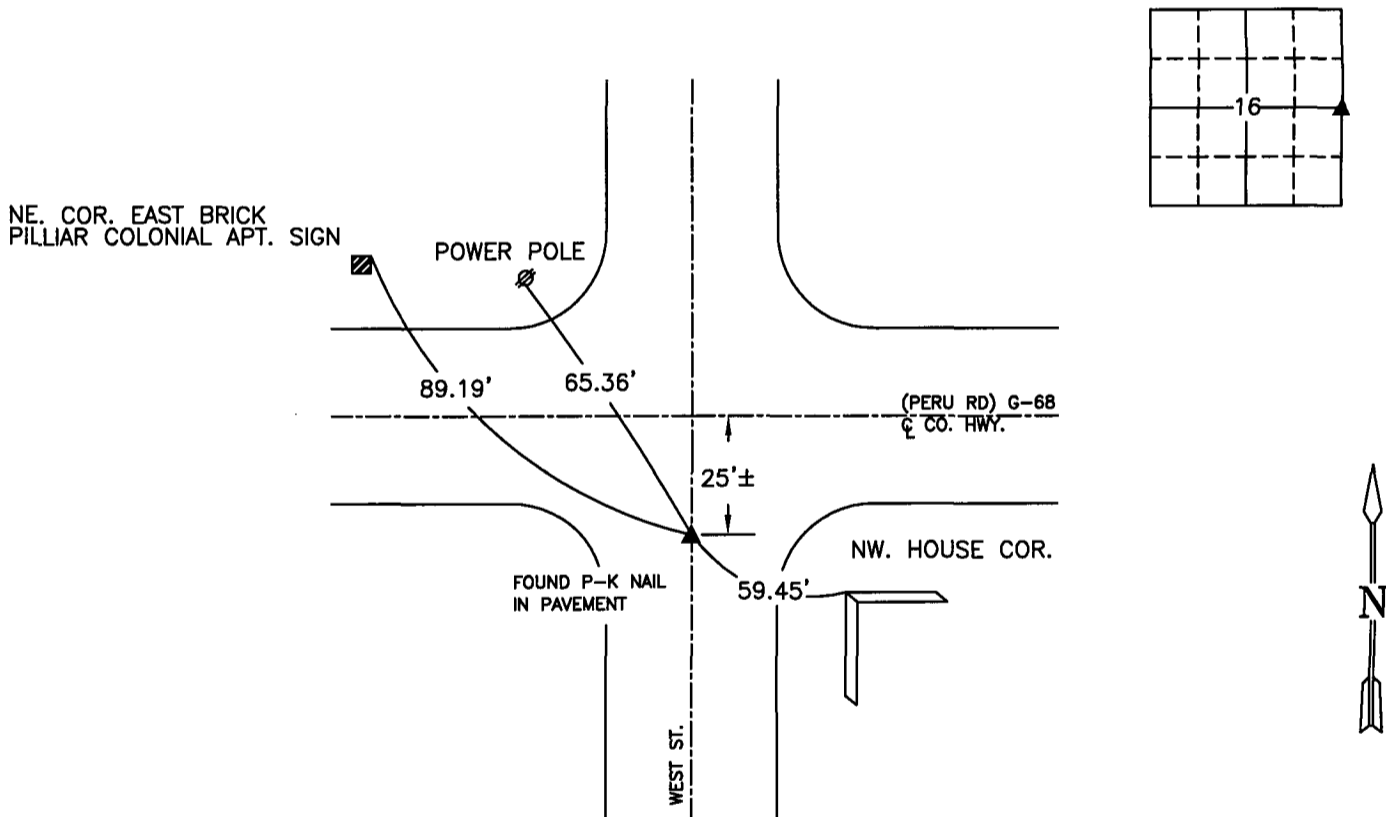

SE. COR., NE. 1/4, SEC. 16

NOTE: ALL TIES TO "X" NAILS UNLESS NOTED

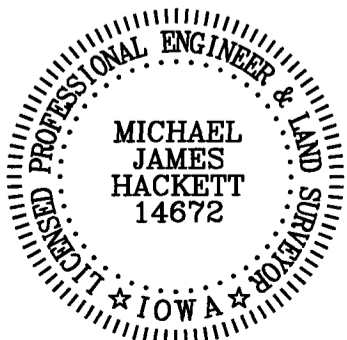

I hereby certify that this land surveying document was prepared and the related survey work was performed by me or under my direct personal supervision and that I am a duly Licensed Land Surveyor under the laws of the State of Iowa.

Signed [Signature] Date 7-28-2014  
Michael James Hackett

Iowa license number 14672.  
My license renewal date is 12/31/2014.  
Pages covered by this seal: 1.