

Book 2014 Page 1822 Type 06 043 Pages 1 Date 7/28/2014 Time 12:19 PM

Rec Amt \$.00

INDX ANNO V SCAN

LISA SMITH, COUNTY RECORDER MADISON COUNTY IOWA

CHEK


Prepared By: Michael James Hackett, Madison County Engineer's Office, 1105 E. Court Ave., Winterset, la. 50273, Tel. (515) 462-1136

UNITED STATES PUBLIC LAND SURVEY CORNER CERTIFICATE OF

Land Survey Monuments situated in Section 12	, Township	<u>74 N</u> , Range
Previously recorded in Book 2007, Page 4091	in County	County,lowa Recorder's Office
(book, page, document number,etc.)	•	
(Show reason for preparing this certificate, the evidence and detailed procedures monumentation found or placed.)	s used in establishing t	he corner positions an
Monument Description and Remarks: Previous monument disturbed	ed during Madison Cou	unty project
FM-C061(93)55-61 A.C.C. pavement resurfacing and reconstruction. S	et P.K. nail in A.C.C.	pavement. The
corner position was established by using existing found monument, existing	ties, and reestablish	ed ties after the
resurfacing and reconstruction. Accepted position.		


PLAN VIEW

(Show a minimum of three reference ties to durable physical objects, relevant monuments and physical conditions that will enable recovery of the corner.)

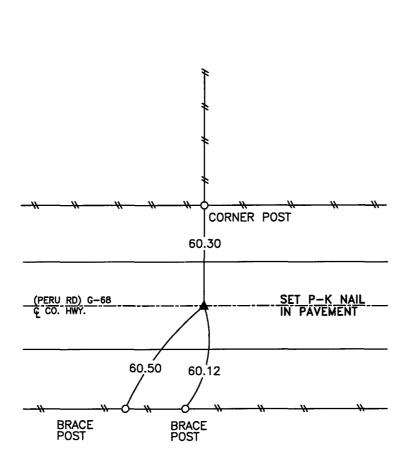

SE. COR., SW. 1/4 SEC. 12

NOTE: ALL TIES TO "X" NAILS UNLESS NOTED

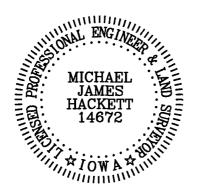

I hereby certify that this land surveying document was prepared and the related survey work was performed by me or under my direct personal supervision and that I am a dufy Licensed Land Surveyor under the laws of the State of Iowa.

12 Date 7-28.2014 Signed-

Michael James Hackett lowa license number 14672. My license renewal date is 12/31/2014. Pages covered by this seal: 1.

FM-C061(93)--55-61