Document 2014 1826

Book 2014 Page 1826 Type 06 043 Pages 1
Date 7/28/2014 Time 12:23 PM
Rec Amt $.00

INDX ✓
ANNO ✓
SCAN

LISA SMITH, COUNTY RECORDER
MADISON COUNTY IOWA

CHEK

Prepared By: Michael James Hackett, Madison County Engineer's Office, 1105 E. Court Ave., Winterset, Ia. 50273, Tel. (515) 462-1136

UNITED STATES PUBLIC LAND SURVEY CORNER CERTIFICATE OF


Land Survey Monuments situated in Section 3, Township 74 N, Range 27 W, of the Fifth Principal Meridian, Madison County,Iowa.
Previously recorded in Book 1, Page 135 in County Recorder's Office.
(book, page, document number,etc.)

(Show reason for preparing this certificate, the evidence and detailed procedures used in establishing the corner positions and monumentation found or placed.)

Monument Description and Remarks: Found 1/2"capped iron pin yellow cap #5041 12" Deep. The existing tie information was checked before Madison County highway maintenance project FM-C061(93)--55-61 A.C.C. pavement resurfacing and reconstruction. Accepted position. The reason for preparing this certificate is because the existing ties distances varied from previously recorded.

PLAN VIEW

(Show a minimum of three reference ties to durable physical objects, relevant monuments and physical conditions that will enable recovery of the corner.)

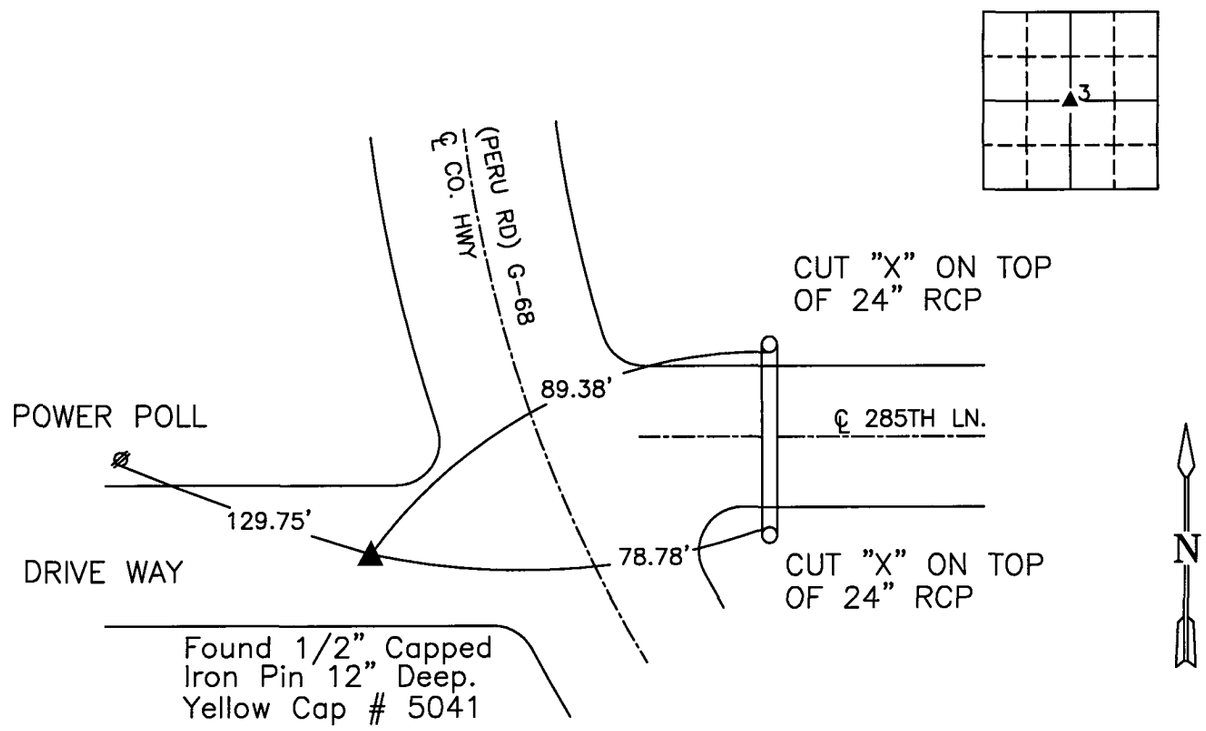

NE. COR., SW. 1/4 SEC. 3

NOTE: ALL TIES TO "X" NAILS UNLESS NOTED

PROFESSIONAL ENGINEER & LAND SURVEYOR
MICHAEL JAMES HACKETT
14672
LICENSED
IOWA

I hereby certify that this land surveying document was prepared and the related survey work was performed by me or under my direct personal supervision and that I am a duly Licensed Land Surveyor under the laws of the State of Iowa.

Signed _____ Date 7-28-2014
Michael James Hackett

Iowa license number 14672.
My license renewal date is 12/31/2014.
Pages covered by this seal: 1.