Document 2014 2183


Book 2014 Page 2183 Type 06 026 Pages 1 Date 9/02/2014 Time 11:17 AM


Rec Amt \$7.00

INDX ANNO SCAN

LISA SMITH, COUNTY RECORDER MADISON COUNTY IOWA

CHEK

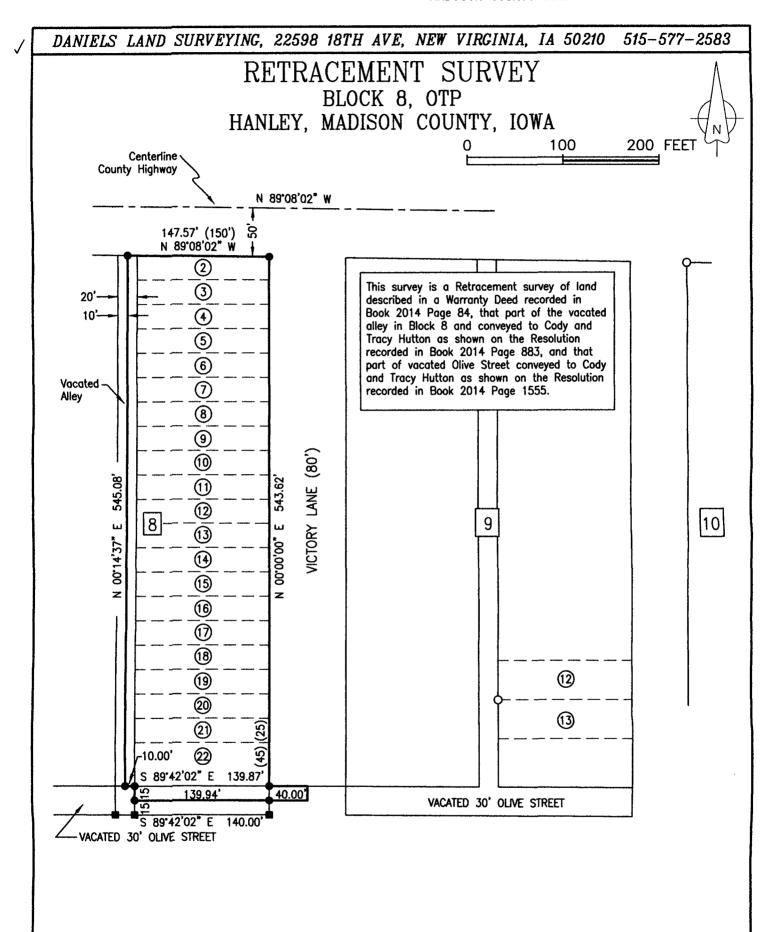


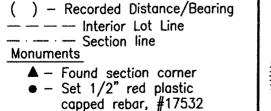

capped rebar, #17532

- Found 5/8" YCIR #7044

- Found 5/8" Rebar

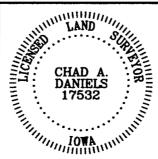

I hereby certify that this surveying document was prepared by me and the related survey work was performed by me or under my direct personal supervision and that I am a duly licensed Land Surveyor under the laws of the State of Iowa.

Signed Chad A. Daniels Date

lowa License No. 17532 My license renewal date is 12-31-2014 Page No.'s covered by this seal: 1

SURVEY FOR AND OWNER: Cody and Tracy Hutton, 3222 260th Ct., St. Charles IA 50240

PROJ. NO. 544

DATE OF SURVEY: 08/22/2014

PAGE 1 of 1