



Document 2014 GW2490

Book 2014 Page 2490 Type 43 001 Pages 3  
Date 10/03/2014 Time 11:01 AM  
Rec Amt \$.00

INDX  
ANNO  
SCAN  
CHEK

LISA SMITH, COUNTY RECORDER  
MADISON COUNTY IOWA



**REAL ESTATE TRANSFER - GROUNDWATER HAZARD STATEMENT**  
TO BE COMPLETED BY TRANSFEROR

**TRANSFEROR:**

Name DENNIS E. SMITH AND ANGELIA SMITH

Address	214 N HARTMAN	ST. CHARLES	IA	50240
	Number and Street or RR	City, Town or P.O.	State	Zip

**TRANSFeree:**

Name CITIMORTGAGE, INC.

Address	3950 REGENT BLVD	IRVING	TX	75063
	Number and Street or RR	City, Town or P.O.	State	Zip

Address of Property Transferred:

214 N HARTMAN	ST. CHARLES	IA	50240
Number and Street or RR	City, Town or P.O.	State	Zip

Legal Description of Property: (Attach if necessary)

Lot One (1) in Block Two (2) of BEAVER AND PATTON'S ADDITION to the Town of St. Charles, Madison County, Iowa

**1. Wells (check one)**

- There are no known wells situated on this property.
- There is a well or wells situated on this property. The type(s), location(s) and legal status are stated below or set forth on an attached separate sheet, as necessary.

**2. Solid Waste Disposal (check one)**

- There is no known solid waste disposal site on this property.
- There is a solid waste disposal site on this property and information related thereto is provided in Attachment #1, attached to this document.

**3. Hazardous Wastes (check one)**

- There is no known hazardous waste on this property.
- There is hazardous waste on this property and information related thereto is provided in Attachment #1, attached to this document.

**4. Underground Storage Tanks (check one)**

- There are no known underground storage tanks on this property. (Note exclusions such as small farm and residential motor fuel tanks, most heating oil tanks, cisterns and septic tanks, in instructions.)
- There is an underground storage tank on this property. The type(s), size(s) and any known substance(s) contained are listed below or on an attached separate sheet, as necessary.

**5. Private Burial Site (check one)**

- There are no known private burial sites on this property.
- There is a private burial site on this property. The location(s) of the site(s) and known identifying information of the decedent(s) is stated below or on an attached separate sheet, as necessary.

**6. Private Sewage Disposal System (check one)**

- All buildings on this property are served by a public or semi-public sewage disposal system.
- This transaction does not involve the transfer of any building which has or is required by law to have a sewage disposal system.
- There is a building served by private sewage disposal system on this property or a building without any lawful sewage disposal system. A certified inspector's report is attached which documents the condition of the private sewage disposal system and whether any modifications are required to conform to standards adopted by the Department of Natural Resources. A certified inspection report must be accompanied by this form when recording.
- There is a building served by private sewage disposal system on this property. Weather or other temporary physical conditions prevent the certified inspection of the private sewage disposal system from being conducted. The buyer has executed a binding acknowledgment with the county board of health to conduct a certified inspection of the private sewage disposal system at the earliest practicable time and to be responsible for any required modifications to the private sewage disposal system as identified by the certified inspection. A copy of the binding acknowledgment is attached to this form.
- There is a building served by private sewage disposal system on this property. The buyer has executed a binding acknowledgment with the county board of health to install a new private sewage disposal system on this property within an agreed upon time period. A copy of the binding acknowledgment is provided with this form.
- There is a building served by private sewage disposal system on this property. The building to which the sewage disposal system is connected will be demolished without being occupied. The buyer has executed a binding acknowledgment with the county board of health to demolish the building within an agreed upon time period. A copy of the binding acknowledgment is provided with this form. [Exemption #9]
- This property is exempt from the private sewage disposal inspection requirements pursuant to the following Exemption [Note: for exemption #9 use prior check box]: \_\_\_\_\_
- The private sewage disposal system has been installed within the past two years pursuant to permit number \_\_\_\_\_

**Information required by statements checked above should be provided here or on separate sheets attached hereto:**

---

---

---

---


---

**I HEREBY DECLARE THAT I HAVE REVIEWED THE INSTRUCTIONS FOR THIS FORM  
AND THAT THE INFORMATION STATED ABOVE IS TRUE AND CORRECT.**

Signature: Herminie E. Smith Angelica Smith Telephone No.: 515 979 6094  
(Transferor or Agent)

214


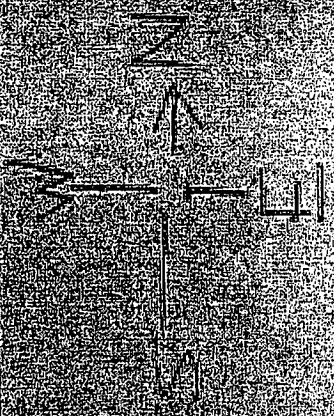

Time 2

Well

Back

House

Front

Pro



Type - leg & status unknown