Document 2015 789

Book 2015 Page 789 Type 06 043 Pages 1
Date 3/27/2015 Time 3:31 PM
Rec Amt $7.00

INDX ✓
ANNO
SCAN

LISA SMITH, COUNTY RECORDER
MADISON COUNTY IOWA

CHEK

VANCE & HOCHSTETLER, P.C., CONSULTING ENGINEERS, WINTERSET, IOWA (515) 462-3995
CHARLES T. VANCE, 110 West Green St., Winterset, Iowa, 50273
JAMES M HOCHSTETLER, 110 West Green St., Winterset, Iowa 50273

UNITED STATES PUBLIC LAND SURVEY CORNER CERTIFICATE

OF

15-225

Land Survey Monuments situated in Section 22, Township 77N, Range 26W, of the Fifth Principal Meridian, MADISON County, Iowa.
Previously recorded in _____ in County Recorder's Office.
(book, page, document number, etc.)

(Show reason for preparing this certificate, the evidence and detailed procedures used in establishing the the corner positions and monumentation found or placed.)


Monument Description and Remarks: NW COR SE¼ NW¼ – Set yellow CIR #6808 at old 3 Way property line fence corner.

NW COR NE¼ NW¼ – Set yellow CIR #6808 at old 3 way property line fence corner.

NE COR SE¼ NW¼ – Cut "X" in concrete paving at midpoint on line between N¼ Cor and middle of section

PLAN - VIEW

(Show a minimum of three reference ties to durable physical objects, relevant monuments and physical conditions that will enable recovery of the corner.)

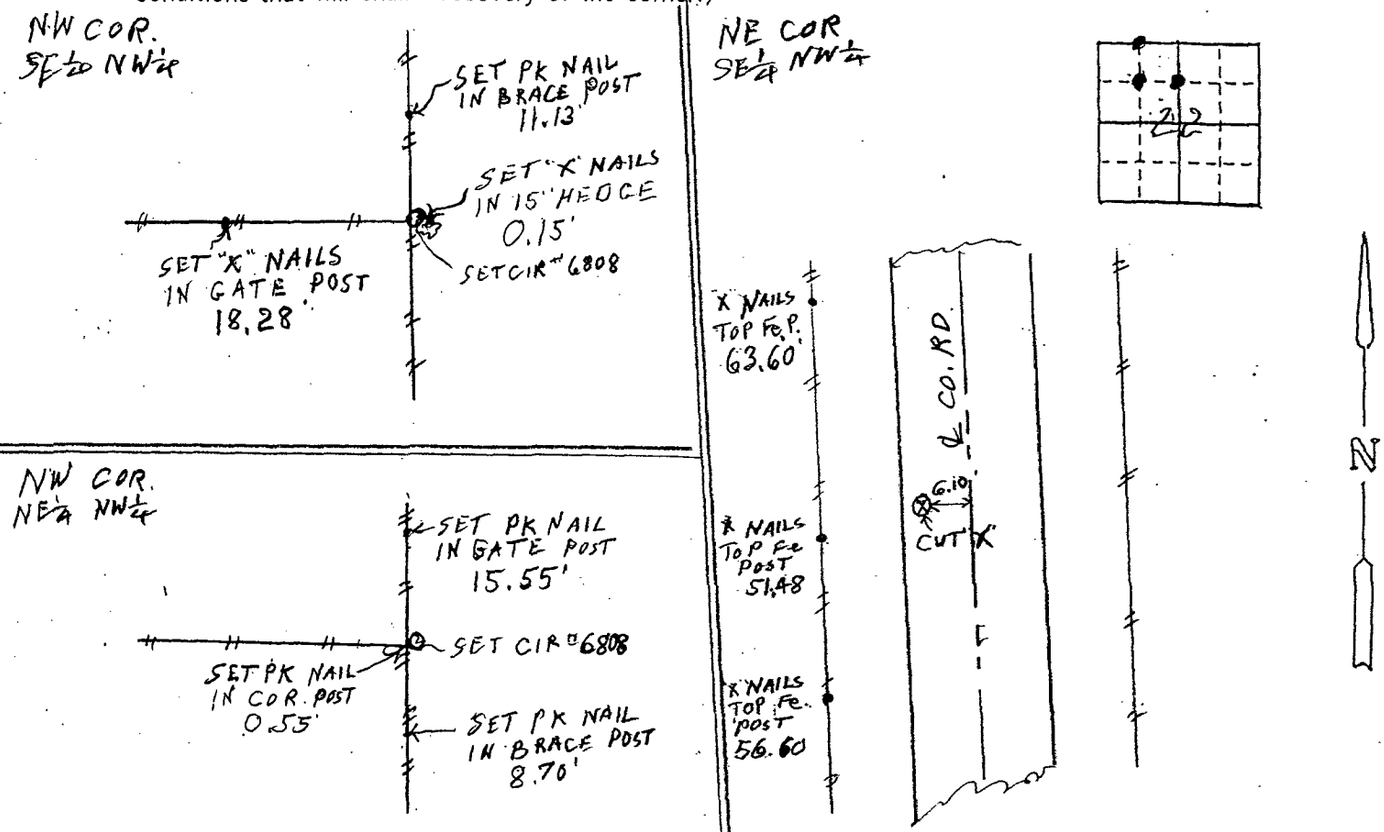

LICENSED LAND SURVEYOR
J. M. HOCHSTETLER
#6808
IOWA

I hereby certify that this land surveying document was prepared and the related survey work was performed by me or under my direct personal supervision and that I am a duly licensed Land Surveyor under the laws of the State of Iowa.

J.M. Hochstetler

J.M. HOCHSTETLER
License number 6808 Date 3/25/15
My license renewal date is December 31 2015
Pages or sheets covered by this seal: 1

List Corners to be Indexed

Corners	Section	Twp	Range
NW COR. SE¼ NW¼	22	77N	26W
NW COR. NE¼ NW¼	22	77N	26W
NE COR SE¼ NW¼	22	77N	26W