



Document 2015 GW828

Book 2015 Page 828 Type 43 001 Pages 3

Date 4/01/2015 Time 9:29 AM

Rec Amt \$.00

INDX
ANNO
SCAN

LISA SMITH, COUNTY RECORDER
MADISON COUNTY IOWA

CHEK

**REAL ESTATE TRANSFER - GROUNDWATER HAZARD STATEMENT
TO BE COMPLETED BY TRANSFEROR**

TRANSFEROR:

Name LANNY L. WENCK

Address	<u>124 W HIGHWAY 92</u>	<u>WINTERSET</u>	<u>IA</u>	<u>50273</u>
	Number and Street or RR	City, Town or PO	State	Zip

TRANSFeree:

Name JASON L KLEEMEIER & JESSICA A KLEEMEIER

Address	<u>1320 W JEFFERSON</u>	<u>WINTERSET</u>	<u>IA</u>	<u>50273</u>
	Number and Street or RR	City, Town or PO	State	Zip

Address of Property Transferred:

Number and Street or RR	City, Town or PO	State	Zip
-------------------------	------------------	-------	-----

Legal Description of Property: (Attach if necessary)

SEE ATTACHED ADDENDUM

1. Wells (check one)

- There are no known wells situated on this property.
- There is a well or wells situated on this property. The type(s), location(s) and legal status are stated below or set forth on an attached separate sheet, as necessary.

2. Solid Waste Disposal (check one)

- There is no known solid waste disposal site on this property.
- There is a solid waste disposal site on this property and information related thereto is provided in Attachment #1, attached to this document.

3. Hazardous Wastes (check one)

- There is no known hazardous waste on this property.
- There is hazardous waste on this property and information related thereto is provided in Attachment #1, attached to this document.

4. Underground Storage Tanks (check one)

- There are no known underground storage tanks on this property. (Note exclusions such as small farm and residential motor fuel tanks, most heating oil tanks, cisterns and septic tanks, in instructions.)
- There is an underground storage tank on this property. The type(s), size(s) and any known substance(s) contained are listed below or on an attached separate sheet, as necessary.

5. Private Burial Site (check one)

- There are no known private burial sites on this property.
- There is a private burial site on this property. The location(s) of the site(s) and known identifying information of the decedent(s) is stated below or on an attached separate sheet, as necessary.


6. Private Sewage Disposal System (check one)

- All buildings on this property are served by a public or semi-public sewage disposal system.
- This transaction does not involve the transfer of any building which has or is required by law to have a sewage disposal system.
- There is a building served by private sewage disposal system on this property or a building without any lawful sewage disposal system. A certified inspector's report is attached which documents the condition of the private sewage disposal system and whether any modifications are required to conform to standards adopted by the Department of Natural Resources. A certified inspection report must be accompanied by this form when recording.
- There is a building served by private sewage disposal system on this property. Weather or other temporary physical conditions prevent the certified inspection of the private sewage disposal system from being conducted. The buyer has executed a binding acknowledgment with the county board of health to conduct a certified inspection of the private sewage disposal system at the earliest practicable time and to be responsible for any required modifications to the private sewage disposal system as identified by the certified inspection. A copy of the binding acknowledgment is attached to this form.
- There is a building served by private sewage disposal system on this property. The buyer has executed a binding acknowledgment with the county board of health to install a new private sewage disposal system on this property within an agreed upon time period. A copy of the binding acknowledgment is provided with this form.
- There is a building served by private sewage disposal system on this property. The building to which the sewage disposal system is connected will be demolished without being occupied. The buyer has executed a binding acknowledgment with the county board of health to demolish the building within an agreed upon time period. A copy of the binding acknowledgment is provided with this form. [Exemption #9]
- This property is exempt from the private sewage disposal inspection requirements pursuant to the following Exemption [Note: for exemption #9 use prior check box]: _____
- The private sewage disposal system has been installed within the past two years pursuant to permit number _____

Information required by statements checked above should be provided here or on separate sheets attached hereto:

I HEREBY DECLARE THAT I HAVE REVIEWED THE INSTRUCTIONS FOR THIS FORM AND THAT THE INFORMATION STATED ABOVE IS TRUE AND CORRECT.

Signature: _____

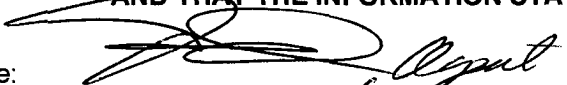


(Transferor or Agent)

Telephone No.: _____

515 681-8350

Addendum to Real Estate Contract Wenck / Fleemener

PLAT OF SURVEY IN THE NORTH HALF OF THE SOUTHEAST QUARTER OF SECTION 10,
TOWNSHIP 75 NORTH, RANGE 28 WEST OF THE 5TH P.M., MADISON COUNTY, IOWA.
OWNED BY: LANNY L. WENCK

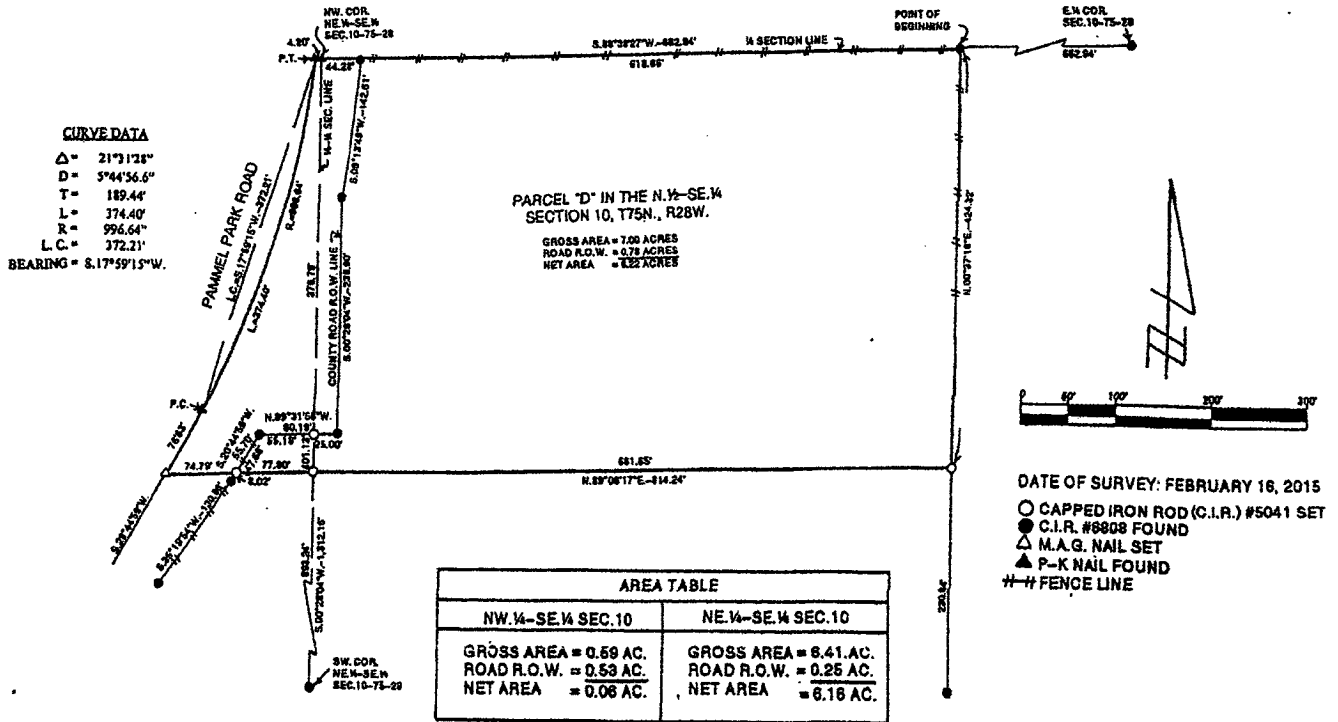

LEGAL DESCRIPTION:

Parcel "D" in the North Half of the Southeast Quarter of Section 10, Township 75 North, Range 28 West of the 5th P.M., Madison County, Iowa more particularly described as follows:

Commencing at the East Quarter Corner of Section 10, Township 75 North, Range 28 West of the 5th P.M., Madison County, Iowa; thence along the Quarter Section Line, South $88^{\circ}38'27''$ West, 662.94 feet to the Point of Beginning. Thence continuing along said Quarter Section Line South $88^{\circ}38'27''$ West, 662.94 feet to the Northwest Corner of the Northeast Quarter of the Southeast Quarter of Section 10; thence continuing South $88^{\circ}38'27''$ West, 4.20 feet to a point on the centerline of Pammel Park Road; thence along said Road centerline Southwesterly 374.40 feet on a 996.64 foot radius curve concave Northwesterly with a central angle of $21^{\circ}31'28''$ Right and a long chord bearing South $17^{\circ}59'15''$ West, 372.21 feet and said curve being tangent to the following course; thence South $28^{\circ}44'59''$ West, 76.63 feet; thence departing Pammel Park Road, North $89^{\circ}06'17''$ East, 152.59 feet to a point on the West Line of the Northeast Quarter of the Southeast Quarter of said Section 10; thence continuing North $89^{\circ}06'17''$ East, 661.65 feet; thence North $00^{\circ}37'18''$ East, 424.32 feet to the Point of Beginning and containing 7.00 Acres including 0.78 Acres of Road Right of Way.