



Document 2015 1122

Book 2015 Page 1122 Type 06 026 Pages 1

Date 5/01/2015 Time 3:11 PM

Rec Amt \$7.00

INDEX ✓
ANNO
SCAN
CHEK



LISA SMITH, COUNTY RECORDER
MADISON COUNTY IOWA

VANCE & HOCHSTETLER, P.C. • CONSULTING ENGINEERS • WINTERSET, IOWA 50273

15-595

CHARLES T. VANCE • 110 WEST GREEN ST., WINTERSET, IOWA • (515) 462-3995
JAMES M. HOCHSTETLER • 110 WEST GREEN ST., WINTERSET, IOWA • FAX: (515) 462-9845

PLAT OF SURVEY OF LOT 4, BLOCK 18, LAUGHRIDGE & CASSIDY'S
ADDITION, CITY OF WINTERSET, MADISON COUNTY, IOWA
OWNED BY JUSTIN A. & MIRANDA E. MARK.

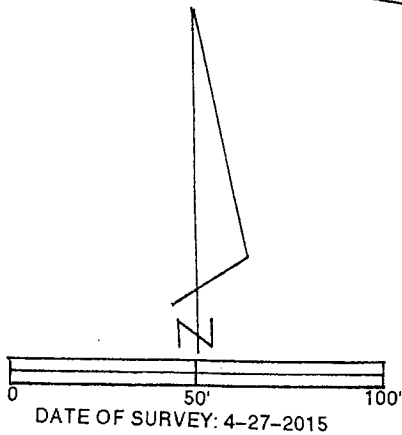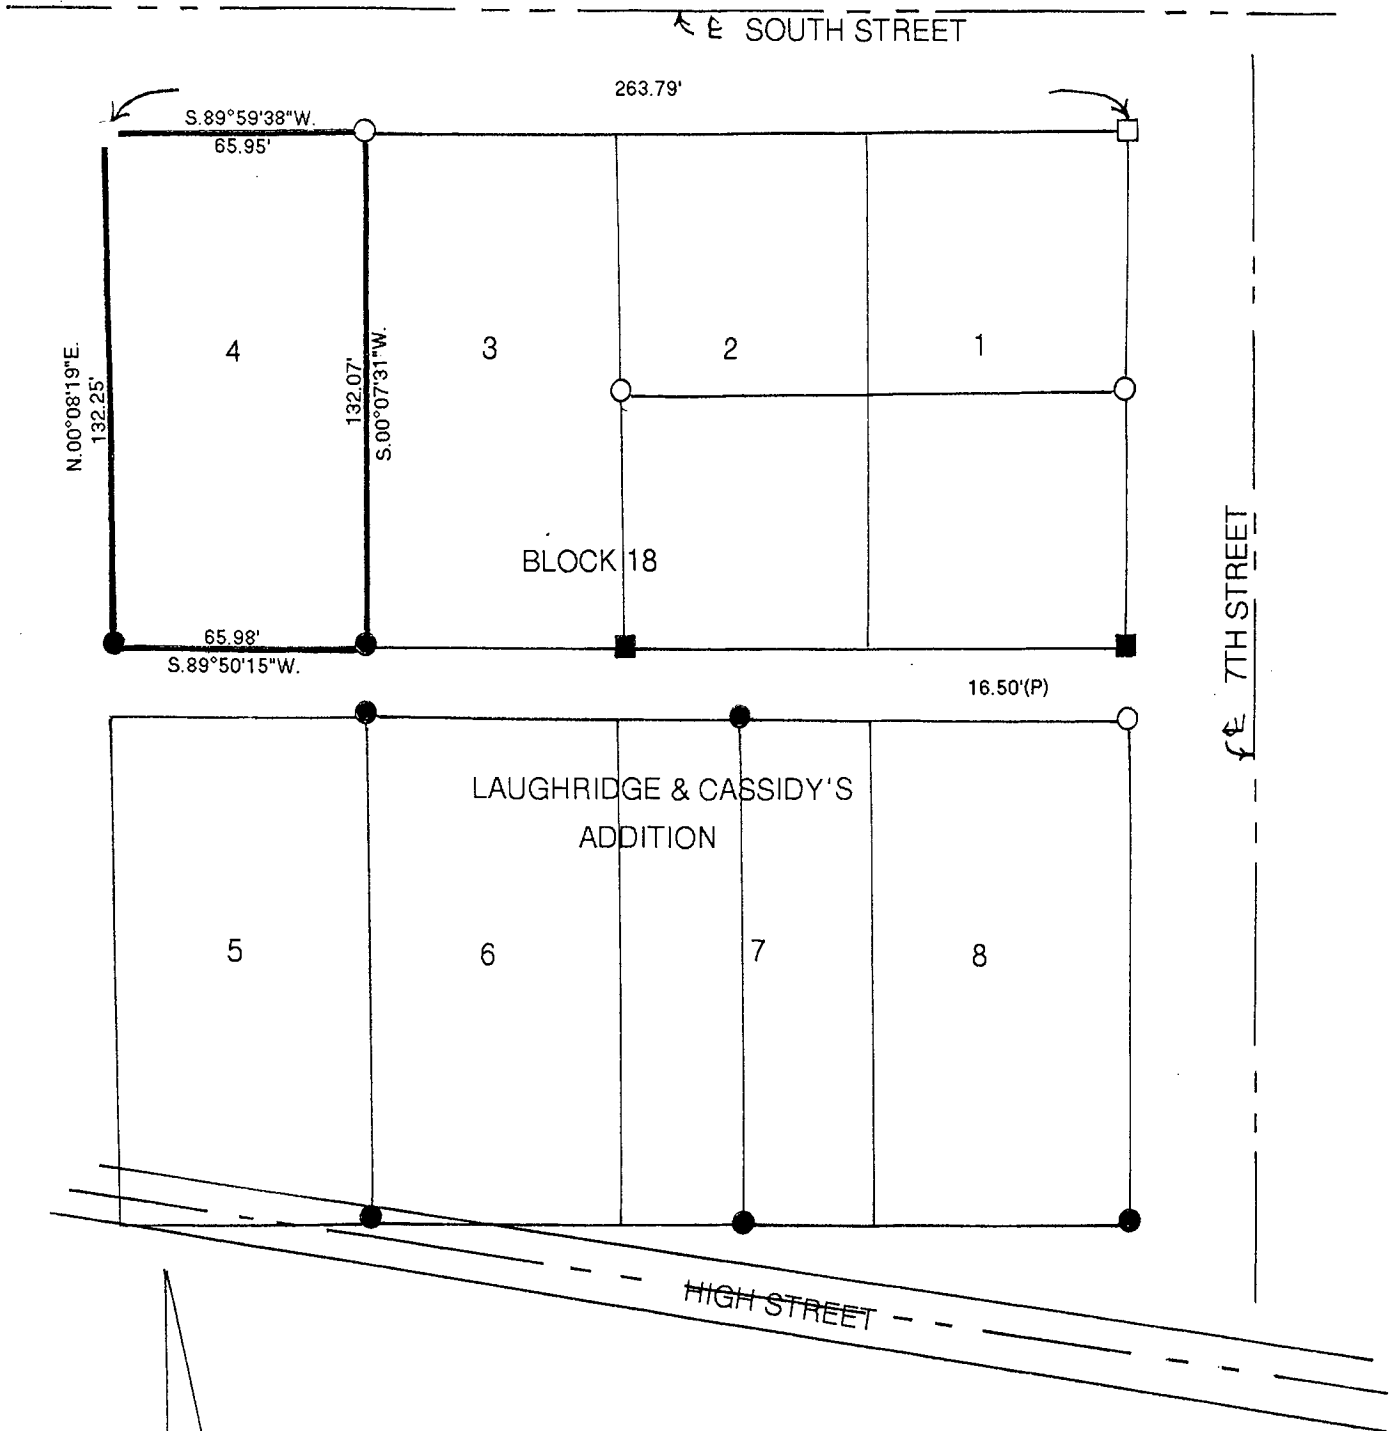

- CAPPED IRON ROD (CIR) #6808 SET
- CIR FOUND
- 1/2" IRON ROD FOUND

LICENSED LAND SURVEYOR

J. M.
HOCHSTETLER
#6808

IOWA

I hereby certify that this land surveying document was prepared and the related survey work was performed by me or under my direct personal supervision and that I am a duly licensed Land Surveyor under the laws of the State of Iowa.

J. M. Hochstetler

J.M. HOCHSTETLER
License number 6808 Date 4/30/15
My license renewal date is December 31, 2015
Pages or sheets covered by this seal: 1