



Document 2015 1408

Book 2015 Page 1408 Type 06 047 Pages 2
Date 5/27/2015 Time 3:10:06PM
Rec Amt \$12.00

INDX
ANNO
SCAN
CHEK

LISA SMITH, COUNTY RECORDER
MADISON COUNTY IOWA

Recorder's Cover Sheet

WIND FARM EASEMENT (Supplemental Exhibit)

Preparer Information:

Steve Dryden, P.O. Box 439, De Soto, IA 50069; 515-834-2059

Taxpayer Information:

N/A

EV

Return Address

MidAmerican Energy Company, Attn: Jamie A. Baker, 4299 Northwest Urbandale Drive,
Urbandale, IA 50322 515-242-3980 *E: PO BOX 657, DSM, IA 50306*

Grantors:

Leroy J. Villwok and Donna R. Villwok, husband and wife, Trustees of the Leroy J. Villwok and
Donna R. Villwok Joint Living Trust dated October 18, 2005

Grantees:


Macksburg Wind Energy LLC

Legal Description: See legal description in Exhibit A of the Memorandum of Wind Farm
Easement Agreement referenced below.

Document or instrument number if applicable:

The attached As-Built drawing is the **Exhibit C** referred to in the Memorandum of Wind Farm
Easement Agreement recorded in **Book 2013 at Page 3063** of the Madison County Records, and
replaces **Exhibit B** attached to that document.

Property # 02

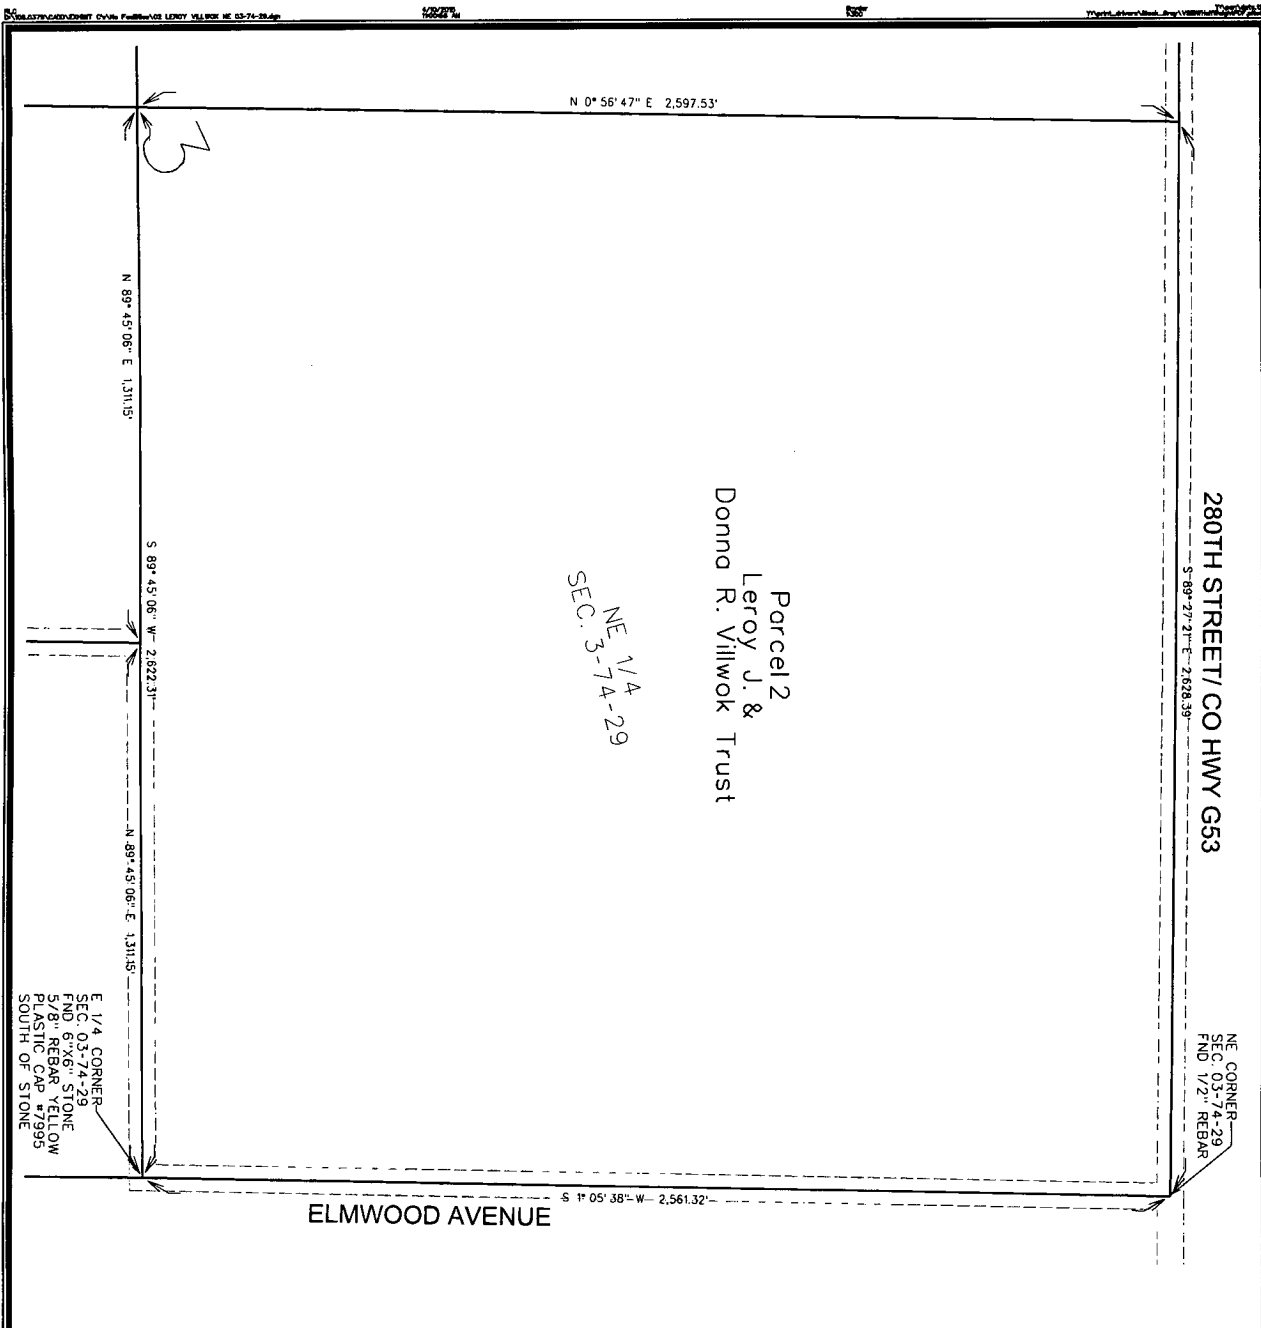

280TH STREET/ CO HWY G55

Parcel 2
Leroy J. &
Donna R. Villwok Trust

NE 1/4
SEC. 3-74-29

NE CORNER
SEC. 03-74-29
FND 1/2" REBAR

ELMWOOD AVENUE

E 1/4 CORNER
SEC. 03-74-29
PLASTIC CAP #7995
SOUTH OF STONE

NO WIND ENERGY FACILITIES ARE LOCATED ON OR OVERHANGING THE PROPERTY DEPICTED IN THIS DRAWING. NO METES AND BOUNDS DESCRIPTION IS PROVIDED (SEE PARAGRAPH 2 OF THE RECORDED MEMORANDUM OF WIND FARM EASEMENT AGREEMENT BECAUSE NO CONSTRUCTION OF WIND FARM EASEMENT, TURBINE SITE EASEMENT, MET TOWER SITE EASEMENT ACCESS EASEMENT, COLLECTION FACILITIES EASEMENT OR OVERHANG EASEMENT IS LOCATED ON THE PROPERTY DEPICTED IN THIS DRAWING.

THIS DRAWING SHALL NOT BE CONSTRUED AS A PROPERTY SURVEY. THIS DRAWING SHALL NOT BE USED FOR THE PURPOSE OF TRANSFERRING TITLE TO THE LAND HEREIN DESCRIBED.

LEGEND


- TURBINE WITH NUMBER
- EASEMENT AREA
- COLLECTION LINE
- PROPERTY BOUNDARY
- PRELIMINARY ACCESS ROAD/ GRAVEL LIMITS
- TRANSFORMER
- JUNCTION BOX
- COLLECTION LINE SPLICE LOCATIONS
- TILE REPAIR LOCATION

NOTES

- 1) UNDERGROUND COLLECTION LINES AND TILE CROSSINGS WERE PROVIDED BY MORTENSON CONSTRUCTION. THE ABOVE-GROUND JUNCTION BOXES AND TRANSFORMERS WERE FIELD SURVEYED.
- 2) THE DIMENSIONS SHOWN ON THE EXHIBIT C DRAWINGS ARE MEASURED HORIZONTALLY, WITH NO CONSIDERATION TO SLOPE OR ELEVATION.
- 3) THE LINEAL FEET (L.F.) SHOWN FOR THE COLLECTION LINE CONTAINS THE CUMULATIVE AMOUNT OF CABLE PATH LENGTH ON THE PROPERTY SHOWN IN THE EXHIBIT.
- 4) THE ACCESSORY IS DIMENSIONED FROM THE TURBINE AS APPLICABLE.
- 5) THE FIELD SURVEY WAS PERFORMED IN OCTOBER THRU DECEMBER 2014.
- 6) EASEMENT SURVEYS AND DIMENSIONS SHOWN PERFORMED USING SPC 1A SOUTH (1402) US SURVEY FT. USING THE IA RTN NETWORK; REFERENCE: NAD83(2011)EPOCH 2010.001.



ISSUE DATE: 04-10-2015

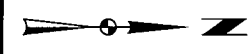

	<p>MIDAMERICAN ENERGY COMPANY-MACKSBURG WIND FARM</p> <p>EXHIBIT C - PARCEL 2 LEROY J. & DONNA R. VILLWOK TRUST</p>	<table border="1" style="width: 100%; border-collapse: collapse;"> <tr> <th>MARK</th> <th>REVISION</th> <th>DATE</th> <th>BY</th> </tr> <tr> <td> </td> <td> </td> <td> </td> <td> </td> </tr> </table>	MARK	REVISION	DATE	BY				
	MARK	REVISION	DATE	BY						
<p>SNYDER & ASSOCIATES, INC.</p> <p>1751 MADISON AVENUE COUNCIL BLUFFS, IA 51503 712-322-3202 www.snyder-associates.com</p>	<p>Project No: 108.0379</p>	<p>Sheet 1 of 1</p>								