Document 2015 2759

Book 2015 Page 2759 Type 06 043 Pages 1
Date 9/18/2015 Time 3:37:58PM
Rec Amt $7.00

INDX ✓
ANNO
SCAN

LISA SMITH, COUNTY RECORDER
MADISON COUNTY IOWA

CHEK

VANCE & HOCHSTETLER,P.C. CONSULTING ENGINEERS, WINTERSET, IOWA (515)462-3995
CHARLES T. VANCE, 110 WEST GREEN ST.,WINTERSET, IOWA 50273
JAMES M. HOCHSTETLER, 110 WEST GREEN ST., WINTERSET, IOWA 50273

UNITED STATES PUBLIC LAND SURVEY CORNER CERTIFICATE

OF

Land Survey Monuments situated in Section 29, Township 76 North, Range 29 West, of the Fifth Principal Meridian, MADISON County, Iowa.
Previously recorded in N/A in County Recorder's Office.
(book, page, document number, etc.)

(Show reason for preparing this certificate, the evidence and detailed procedures used in establishing the corner positions and monumentation found or placed.)


Monument Description and Remarks: N.¼ Cor. was set on E of East-West Road at the intersection with E of Road South and Line Fence North.

S.¼ Cor was set at intersection of E East-West Road and E of North-South Road.


CENTER COR. was set on Line between N.¼ Cor. and S.¼ Cor. at the intersection of an East-West Line between two three way fence corner posts

PLAN - VIEW


(Show a minimum of three reference ties to durable physical objects, relevant monuments and physical conditions that will enable recovery of the corner.)

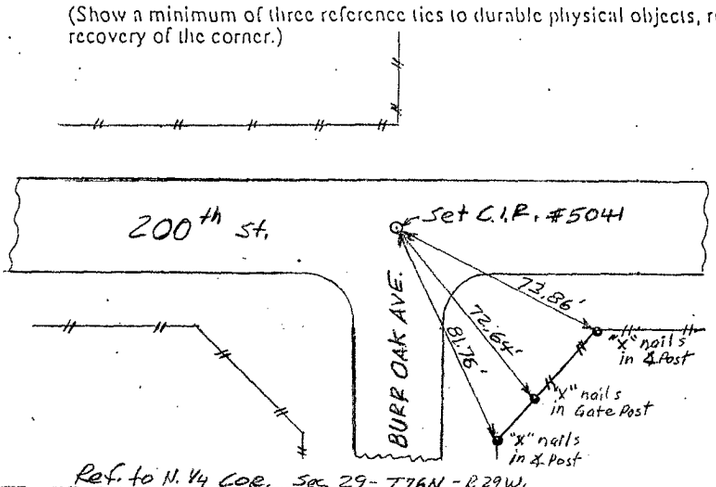


Ref. to N. ¼ Cor. Sec. 29-T76N-R29W.

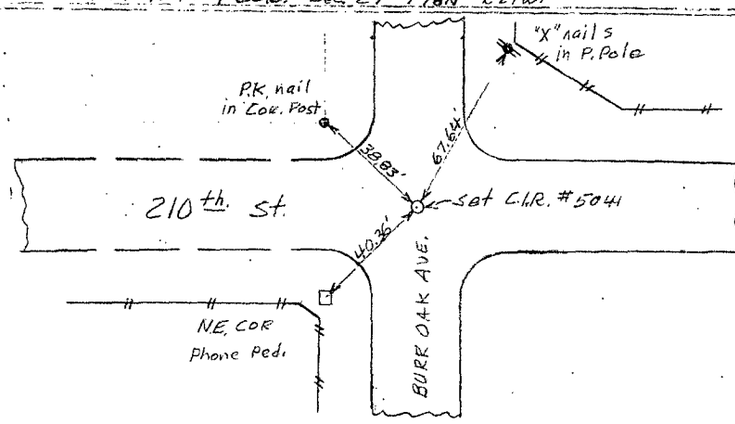

Ref. to S¼ Cor. Sec. 29-T76N-R29W.

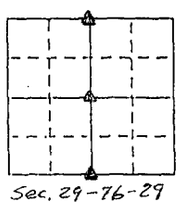

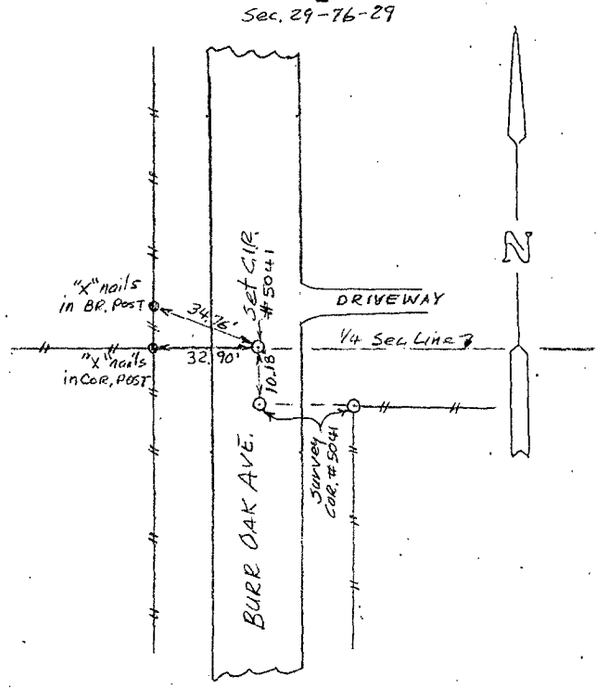

Ref. to CENTER COR. Sec. 29-T76N-R29W.

PROFESSIONAL ENGINEER LICENSED CHARLES T. VANCE 5041 IOWA LAND SURVEYOR

I hereby certify that this land surveying document was prepared and the related survey work was preformed by me or under my direct personal supervision and that I am a.duly Licensed Land Surveyor under the laws of the State of Iowa.

Charles T Vance 27 August 2015
Charles T. Vance, PE & PLS Date

License No. 5041

My License renewal date is 31, December 2015

List Corners to be Indexed

Corners	Section	Twp	Range
N. ¼ Cor	29	76	29
S. ¼ Cor.	29	76	29
CENTER	29	76	29