Document 2015 2761

Book 2015 Page 2761 Type 06 043 Pages 1
Date 9/18/2015 Time 3:37:58PM
Rec Amt $7.00

INDX ✓
ANNO
SCAN

LISA SMITH, COUNTY RECORDER
MADISON COUNTY IOWA

CHEK

15-1225

VANCE & HOCHSTETLER, P.C., CONSULTING ENGINEERS, WINTERSET, IOWA (515) 462-3995
CHARLES T. VANCE, 110 West Green St., Winterset, Iowa, 50273
JAMES M HOCHSTETLER, 110 West Green St., Winterset, Iowa 50273

UNITED STATES PUBLIC LAND SURVEY CORNER CERTIFICATE

OF

Land Survey Monuments situated in Section 32, Township 76 N, Range 27 W, of the Fifth Principal Meridian, MADISON County, Iowa.
Previously recorded in _____ in County Recorder's Office.
(book, page, document number, etc.)


(Show reason for preparing this certificate, the evidence and detailed procedures used in establishing the the corner positions and monumentation found or placed.)

Monument Description and Remarks: SE. COR. SW¼ NE¼ - Set yellow CIR #6808 on line between NE COR SW¼ NE¼ and SE COR SW¼ SE¼ at prorated distance between points.

NE. COR SW¼ NE¼ - Set yellow CIR #6808 at mid distance on line between the NW Cor. SW¼ NE¼ and the NE Cor SE¼ NE¼.

PLAN - VIEW

(Show a minimum of three reference ties to durable physical objects, relevant monuments and physical conditions that will enable recovery of the corner.)

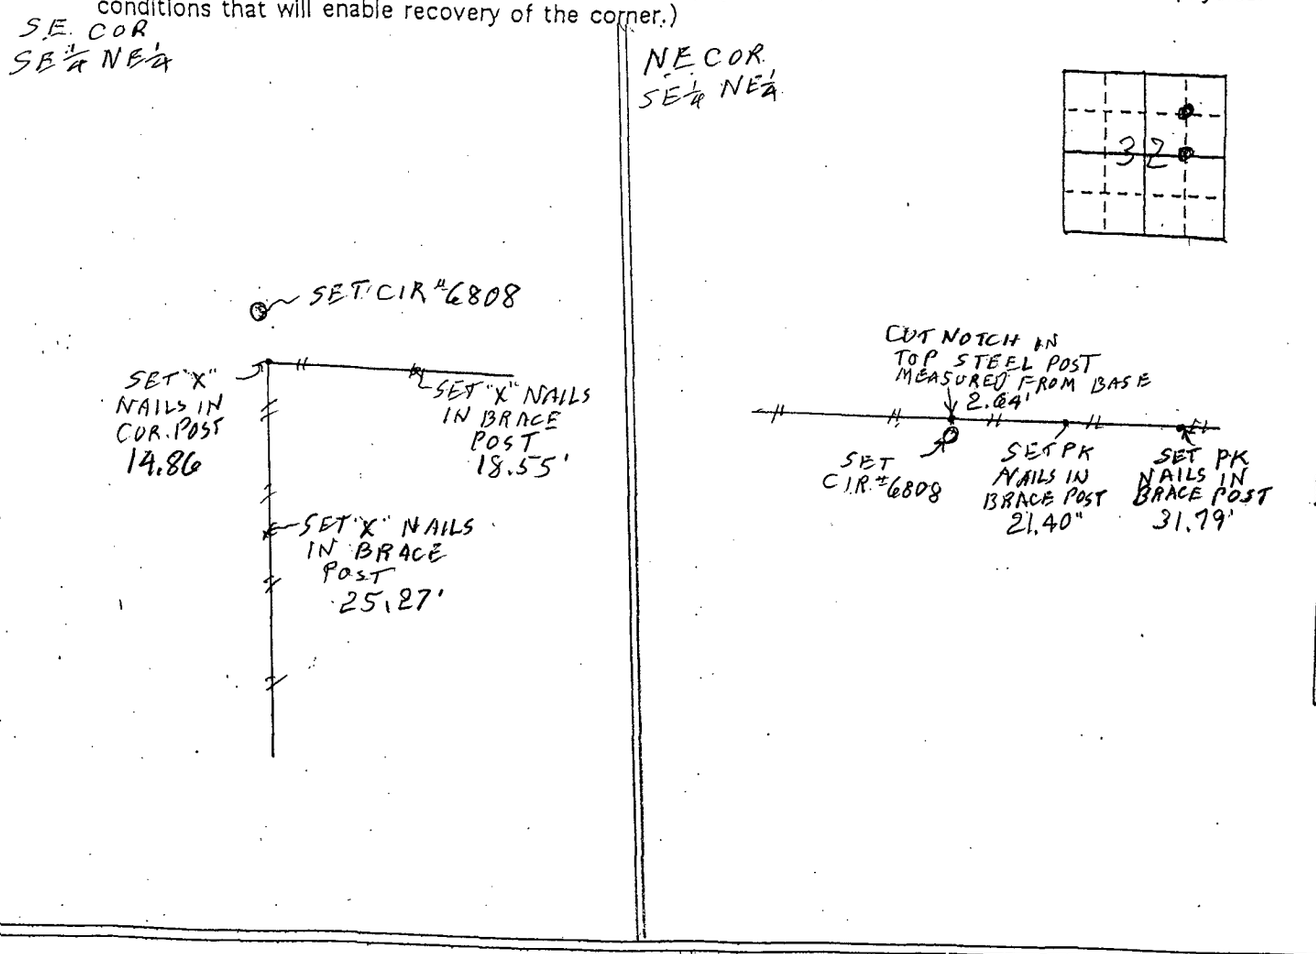

LICENSED LAND SURVEYOR
J. M. HOCHSTETLER
#6808
IOWA

I hereby certify that this land surveying document was prepared and the related survey work was performed by me or under my direct personal supervision and that I am a duly licensed Land Surveyor under the laws of the State of Iowa.

J M Hochstetler

J.M. HOCHSTETLER
License number 6808 Date 9/15/15.
My license renewal date is December 31, 2015
Pages or sheets covered by this seal: 1

List Corners to be Indexed

Corners	Section	Twp	Range
SE COR SE¼ NE¼	32	76N	27W
NE COR SE¼ NE¼	32	76N	27W