Document 2015 2988

Book 2015 Page 2988 Type 06 043 Pages 1
Date 10/09/2015 Time 3:36:59PM
Rec Amt $7.00

INDX ✓
ANNO
SCAN

LISA SMITH, COUNTY RECORDER
MADISON COUNTY IOWA

CHEK

14-1605

VANCE & HOCHSTETLER, P.C., CONSULTING ENGINEERS, WINTERSET, IOWA (515) 462-3995
CHARLES T. VANCE, 110 West Green St., Winterset, Iowa, 50273
JAMES M HOCHSTETLER, 110 West Green St., Winterset, Iowa 50273

UNITED STATES PUBLIC LAND SURVEY CORNER CERTIFICATE

OF

Land Survey Monuments situated in Section 14, Township 75 N, Range 29 W, of the Fifth Principal Meridian, MADISON County, Iowa.
Previously recorded in _____ in County Recorder's Office.
(book, page, document number, etc.)


(Show reason for preparing this certificate, the evidence and detailed procedures used in establishing the the corner positions and monumentation found or placed.)


Monument Description and Remarks: S¼ Cor - Set yellow CIR #6808 at intersection of ℄ of County Road based on found ½ Pipe at SE Cor NE¼ NW¼ Sec. 23 and CIR #13427 with line from found ½ Pipe at SE Cor Sec. 14 to a CIR 13427 at SW Cor. SE¼ SW¼ Sec. 23. Point is in large open grassy area. (Nothing to tie to)

PLAN - VIEW

(Show a minimum of three reference ties to durable physical objects, relevant monuments and physical conditions that will enable recovery of the corner.)

S¼ COR

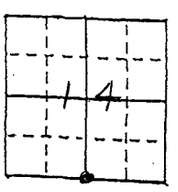

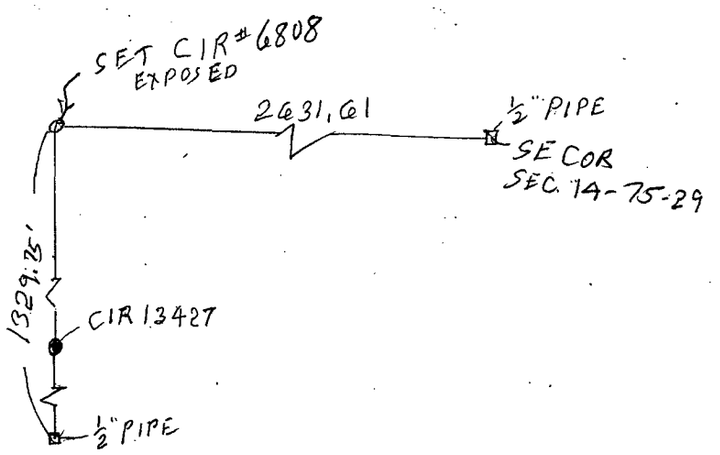

LICENSED LAND SURVEYOR
J. M.
HOCHSTETLER
#6808
IOWA

I hereby certify that this land surveying document was prepared and the related survey work was performed by me or under my direct personal supervision and that I am a duly licensed Land Surveyor under the laws of the State of Iowa.

J.M. Hochstetler

J.M. HOCHSTETLER
License number 6808 Date 9/21/15
My license renewal date is December 31, 2015
Pages or sheets covered by this seal: 1

List Corners to be Indexed

Corners	Section	Twp	Range
S¼ COR	14	75N	27W