



Document 2015 2991

Book 2015 Page 2991 Type 06 026 Pages 1

Date 10/09/2015 Time 3:38:38PM

Rec Amt \$7.00

INDX ✓
ANNO
SCAN



LISA SMITH, COUNTY RECORDER
MADISON COUNTY IOWA

CHEK

✓ VANCE & HOCHSTETLER, P.C. • CONSULTING ENGINEERS • WINTERSET, IOWA 50273

CHARLES T. VANCE • 110 WEST GREEN ST., WINTERSET, IOWA • (515) 462-3995
JAMES M. HOCHSTETLER • 110 WEST GREEN ST., WINTERSET, IOWA • FAX: (515) 462-9845

PLAT OF SURVEY OF WEST 124 FEET OF THE NORTH HALF OF OUTLOT 3, LAUGHRIDGE
& CASSIDAY'S OUTLOTS, CITY OF WINTERSET, MADISON COUNTY, IOWA
OWNED BY MUNDELL NUNEZ GONZALEZ REVOCABLE TRUST.

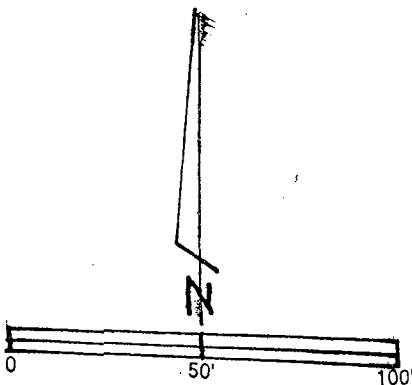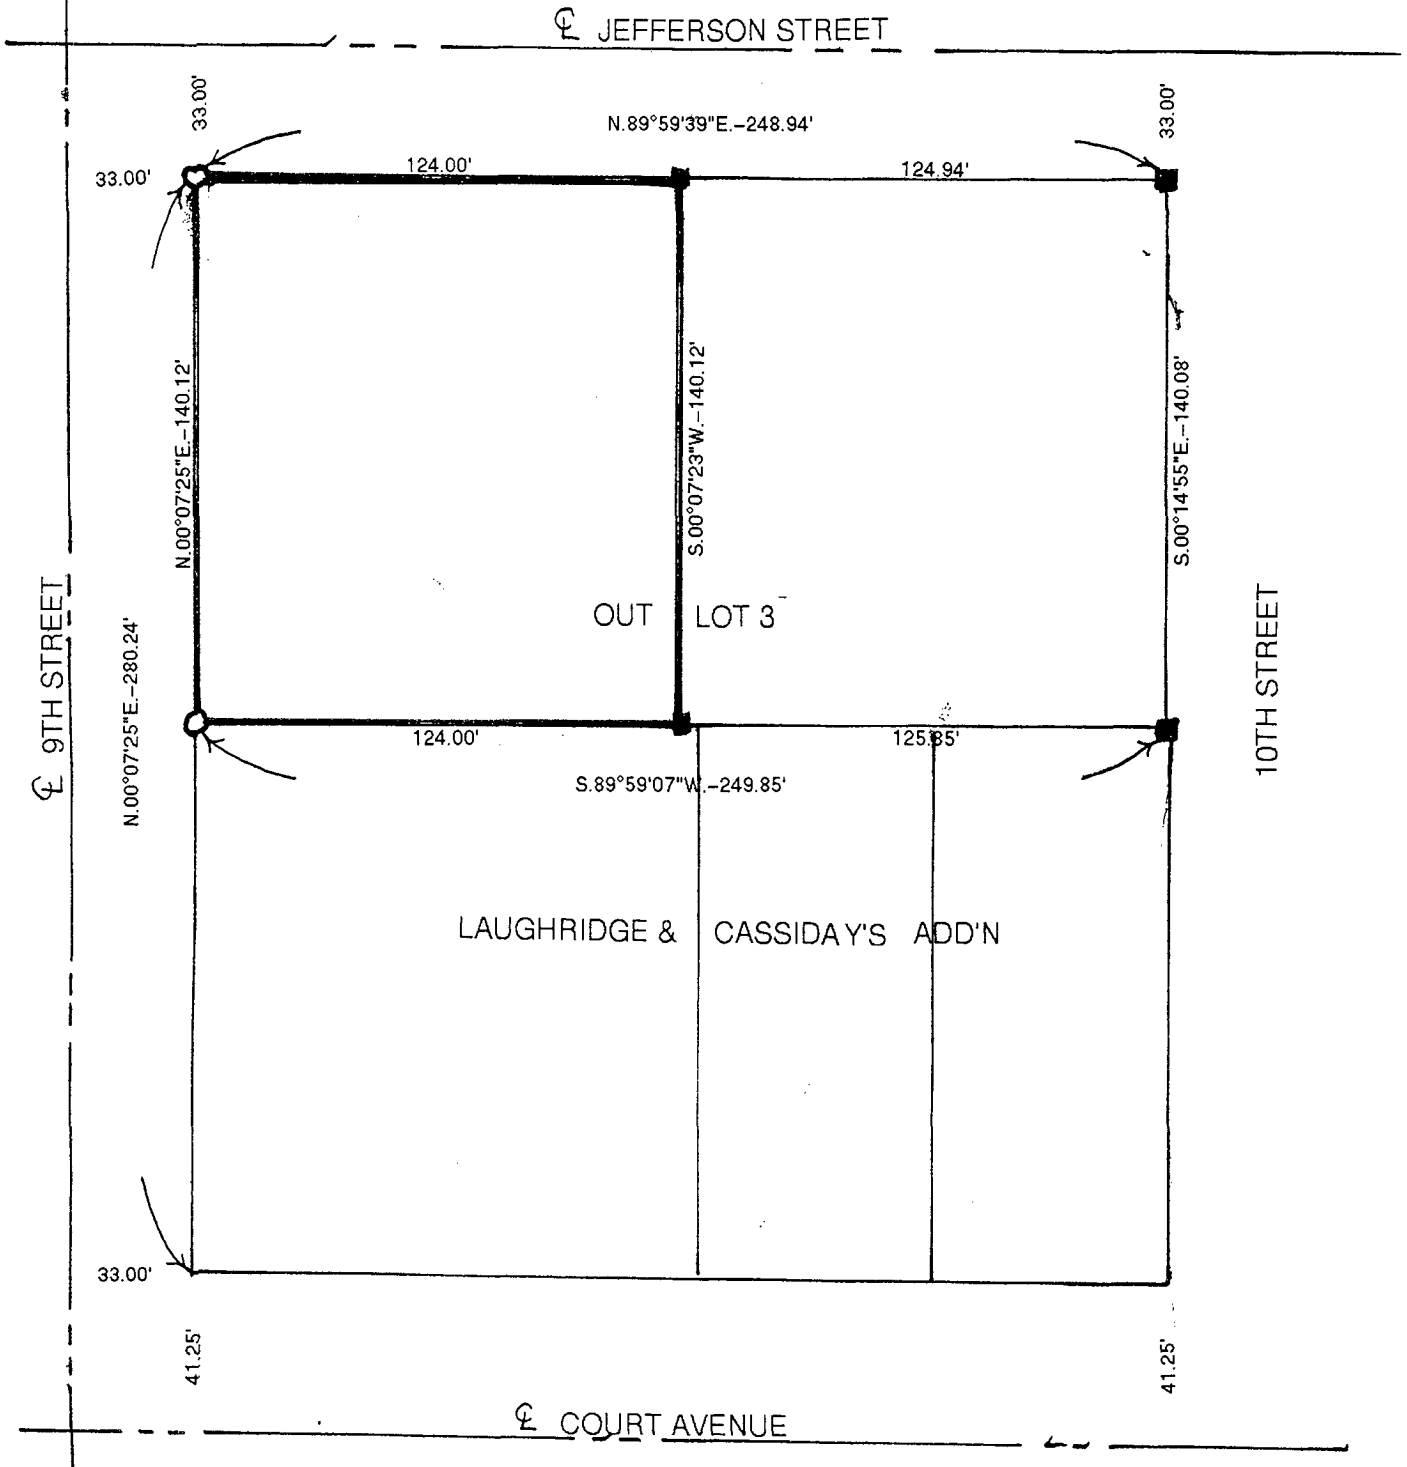

DATE OF SURVEY: 8-28-2015
○ CAPPED IRON ROD (CIR) #6808 SET
■ CIR #5041 FOUND

I hereby certify that this land surveying document was prepared and the related survey work was performed by me or under my direct personal supervision and that I am a duly licensed Land Surveyor under the laws of the State of Iowa.

J. M. Hochstetler
J. M. HOCHSTETLER
License number 6808 Date 9/25/15
My license renewal date is December 31, 2015
Pages or sheets covered by this seal: 1