



Document 2015 GW3480

Book 2015 Page 3480 Type 43 001 Pages 5

Date 11/23/2015 Time 11:07:20AM

Rec Amt \$.00

INDX

ANNO

SCAN

LISA SMITH, COUNTY RECORDER

MADISON COUNTY IOWA

CHEK

**REAL ESTATE TRANSFER - GROUNDWATER HAZARD STATEMENT
TO BE COMPLETED BY TRANSFEROR**

TRANSFEROR:

Name Daniel C. Ahrens and Soni L. Ahrens
Address 3205 Cedar Bridge Road, Winterset, IA 50273
Number and Street or RR City, Town or P.O. State Zip

TRANSFeree:

Name Jason L. Kleemeier and Jessica A. Kleemeier
Address 1320 West Jefferson, Winterset, IA 50273
Number and Street or RR City, Town or P.O. State Zip

Address of Property Transferred:
3205 Cedar Bridge Road, Winterset, IA 50273
Number and Street or RR City, Town or P.O. State Zip

Legal Description of Property: (Attach if necessary) Parcel "A", located in the West Half (1/2) of the Southeast Quarter (1/4) of Section Nineteen (19), Township Seventy-six (76) North, Range Twenty-seven (27) West of the 5th P.M., Madison County, Iowa, as shown in Plat of Survey filed in Book 2, Page 443 on February 28, 1994, in the Office of the Recorder of Madison County, Iowa.

1. Wells (check one)

- There are no known wells situated on this property.
- There is a well or wells situated on this property. The type(s), location(s) and legal status are stated below or set forth on an attached separate sheet, as necessary.

2. Solid Waste Disposal (check one)

- There is no known solid waste disposal site on this property.
- There is a solid waste disposal site on this property and information related thereto is provided in Attachment #1, attached to this document.

3. Hazardous Wastes (check one)

- There is no known hazardous waste on this property.
- There is hazardous waste on this property and information related thereto is provided in Attachment #1, attached to this document.

4. Underground Storage Tanks (check one)

- There are no known underground storage tanks on this property. (Note exclusions such as small farm and residential motor fuel tanks, most heating oil tanks, cisterns and septic tanks, in instructions.)
- There is an underground storage tank on this property. The type(s), size(s) and any known substance(s) contained are listed below or on an attached separate sheet, as necessary.

5. Private Burial Site (check one)

- There are no known private burial sites on this property.
- There is a private burial site on this property. The location(s) of the site(s) and known identifying information of the decedent(s) is stated below or on an attached separate sheet, as necessary.

6. Private Sewage Disposal System (check one)

- All buildings on this property are served by a public or semi-public sewage disposal system.
- This transaction does not involve the transfer of any building which has or is required by law to have a sewage disposal system.
- There is a building served by private sewage disposal system on this property or a building without any lawful sewage disposal system. A certified inspector's report is attached which documents the condition of the private sewage disposal system and whether any modifications are required to conform to standards adopted by the Department of Natural Resources. A certified inspection report must be accompanied by this form when recording.
- There is a building served by private sewage disposal system on this property. Weather or other temporary physical conditions prevent the certified inspection of the private sewage disposal system from being conducted. The buyer has executed a binding acknowledgment with the county board of health to conduct a certified inspection of the private sewage disposal system at the earliest practicable time and to be responsible for any required modifications to the private sewage disposal system as identified by the certified inspection. A copy of the binding acknowledgment is attached to this form.
- There is a building served by private sewage disposal system on this property. The buyer has executed a binding acknowledgment with the county board of health to install a new private sewage disposal system on this property within an agreed upon time period. A copy of the binding acknowledgment is provided with this form.
- There is a building served by private sewage disposal system on this property. The building to which the sewage disposal system is connected will be demolished without being occupied. The buyer has executed a binding acknowledgment with the county board of health to demolish the building within an agreed upon time period. A copy of the binding acknowledgment is provided with this form. [Exemption #9]
- This property is exempt from the private sewage disposal inspection requirements pursuant to the following exemption [Note: for exemption #9 use prior check box]: _____.
- The private sewage disposal system has been installed within the past two years pursuant to permit number _____.

Information required by statements checked above should be provided here or on separate sheets attached hereto:

I HEREBY DECLARE THAT I HAVE REVIEWED THE INSTRUCTIONS FOR THIS FORM AND THAT THE INFORMATION STATED ABOVE IS TRUE AND CORRECT.

Signature: *Soni G. Ahrens* Telephone No.: (515) - 835-0410
(Transferor or Agent)



Seller.

Time of Transfer Inspection Report (DNR Form 542-0191)

Property information

Current owner Dan Ahrens
Buyer _____ Realtor private sale
Mailing address _____

Site Address/County 3205 Cedar Bridge Road Winterset, Ia. 50273
Legal Description Madison Co.

No. of bedrooms 3 Last occupied? is now Records available yes
replace lateral no permit W/installed in 1995
Permit # 118-03 Installation date 9/19/03 Separation distances ok/ no? OK

Septic system information

Septic tank(s): size 1000 gal material concrete condition good
Tank pumped? yes date 3/18/15 licensed pumper Major Septic
Septic/trash/processing tank: size _____ material _____ condition _____
Tank pumped? _____ date _____ licensed pumper _____

Aerobic treatment unit (ATU) mfr _____ size _____
Tank pumped? _____ date _____ licensed pumper _____
Maintenance contract? _____ expiration date _____ service provider _____
Condition _____

Pump tanks/vaults: type _____ size _____ condition _____

Distribution system: distribution box Plastic outlets used 4 condition good
Header pipe(s) 3 # of lines 4 Pressure dosed? _____

Secondary treatment:

length of absorption fields 4 at 100 ft determined by map & probing
condition of fields dry in Mar. 2015 determined by walking & Probing
type of trench material 3 gravel pits + 1 Chamber

Size of sand filter _____ determined by _____
Vent pipes above grade? _____ discharge pipe located? _____
Effluent sample taken? _____ Results _____

Media filters: type _____
Maintenance contract? _____ expiration date _____ service provider _____
Condition _____

NPDES General Permit No. 4: required? _____ permitted? _____ NOI provided _____



Time of Transfer Inspection Report

Other components:

Alarms _____ Working? _____ disinfection _____ working? _____

Control box _____ Timers _____ inspection ports _____

Other components _____

Overall condition of the private sewage disposal system

Report system status: The septic system at 3205 Cedar Bridge Rd

Explain (attach additional pages as needed): Winterset, Ia. 50273

is in workable cond. The septic tank was opened & Pumped
Comments: on Mar of 2015 - tank has 1 Comp & inlet outflow
effluer in place. Tank was opened - July 2015 - water at
correct level & no cracks in tank on year - 2015
The lateral field was clean & dry - in Mar of 2015 - but
when looked at lateral field in July of 2015 the lower
lateral field was wet because of rain

all gray water goes to system

Site status at conclusion of Time of Transfer inspection:

- Verify that controls are set on the appropriate mode.
- Power is on to all components.
- Done Revisit all components to verify lids are secure.
- Done Gather all tools for removal from the site.
- Verify that no sewage is on the ground surface. No sewage on 7-2015 wet w/ rain

Using this worksheet, write a narrative report of the inspection results and attach a site sketch. W/ rain

This report indicates the condition of the private sewage disposal system at the time of the inspection. It does not guarantee that it will continue to function satisfactorily.

Signature of Certified inspector:

Name (print): _____
Address: _____
Phone: 515 462 2624

John W. Mayer
JOHN MAYER
SEPTIC TANK PLUMBING
 1509 St. Hwy. 92
 Winterset, IA 50273-8996


Date: 7-29-2015
Certificate #: 8979

Provide a copy of this report, the narrative report and sketch to the seller/agent, buyer/agent, the county sanitarian/environmental health office, county Recorder in the county the inspection was conducted and to:

Iowa DNR Onsite Wastewater Program
502 E. 9th St.
Des Moines, IA 50319



lower
lateral
field
after
rain
(July 2015)

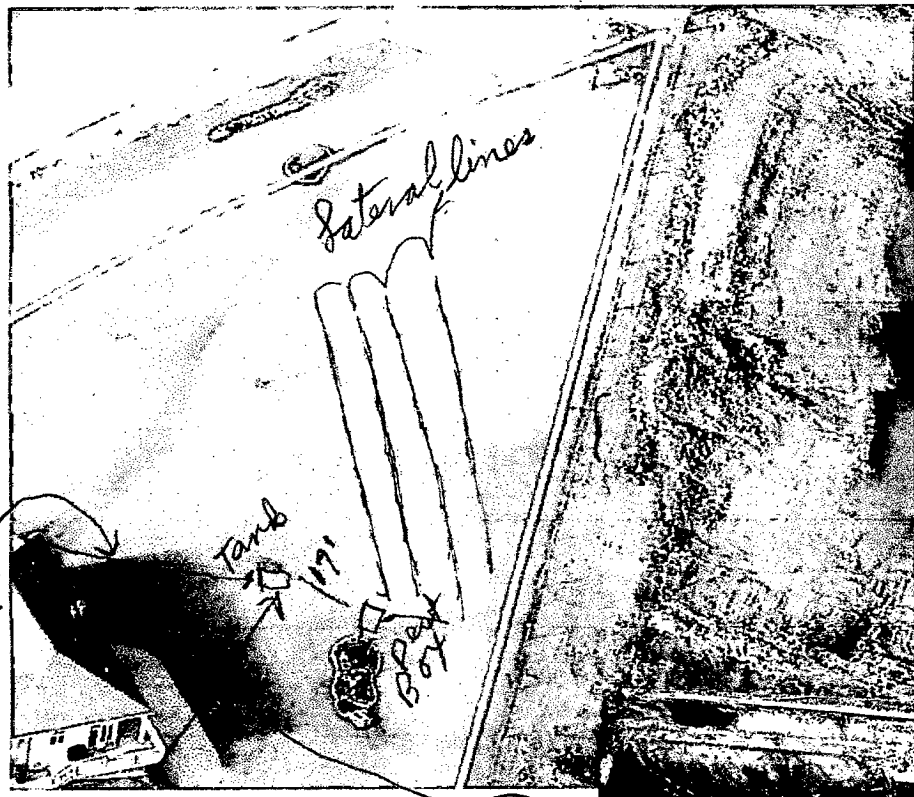

N.E. corner of
house to tank
73'

Dist. Box
↙

Picture taken 3/17/15

Lateral
field dry.
3-17-15

S.E. corner of
house to tank
100'

