



Document 2015 3568

Book 2015 Page 3568 Type 06 026 Pages 1

Date 11/30/2015 Time 3:45:23PM

Rec Amt \$7.00

INDX  
ANNO  
SCAN


LISA SMITH, COUNTY RECORDER  
MADISON COUNTY IOWA

CHEK

**VANCE & HOCHSTETLER, P.C. • CONSULTING ENGINEERS • WINTERSET, IOWA 50273**

CHARLES T. VANCE • 110 WEST GREEN ST., WINTERSET, IOWA • (515) 462-3995  
JAMES M. HOCHSTETLER • 110 WEST GREEN ST., WINTERSET, IOWA • FAX: (515) 462-9845

PLAT OF SURVEY OF LOT 2, BLOCK 13, LAUGHRIDGE &  
CASSIDAY ADDITION, CITY OF WINTERSET, IOWA  
OWNED BY JESSICA & ANDREW HENSLEY.

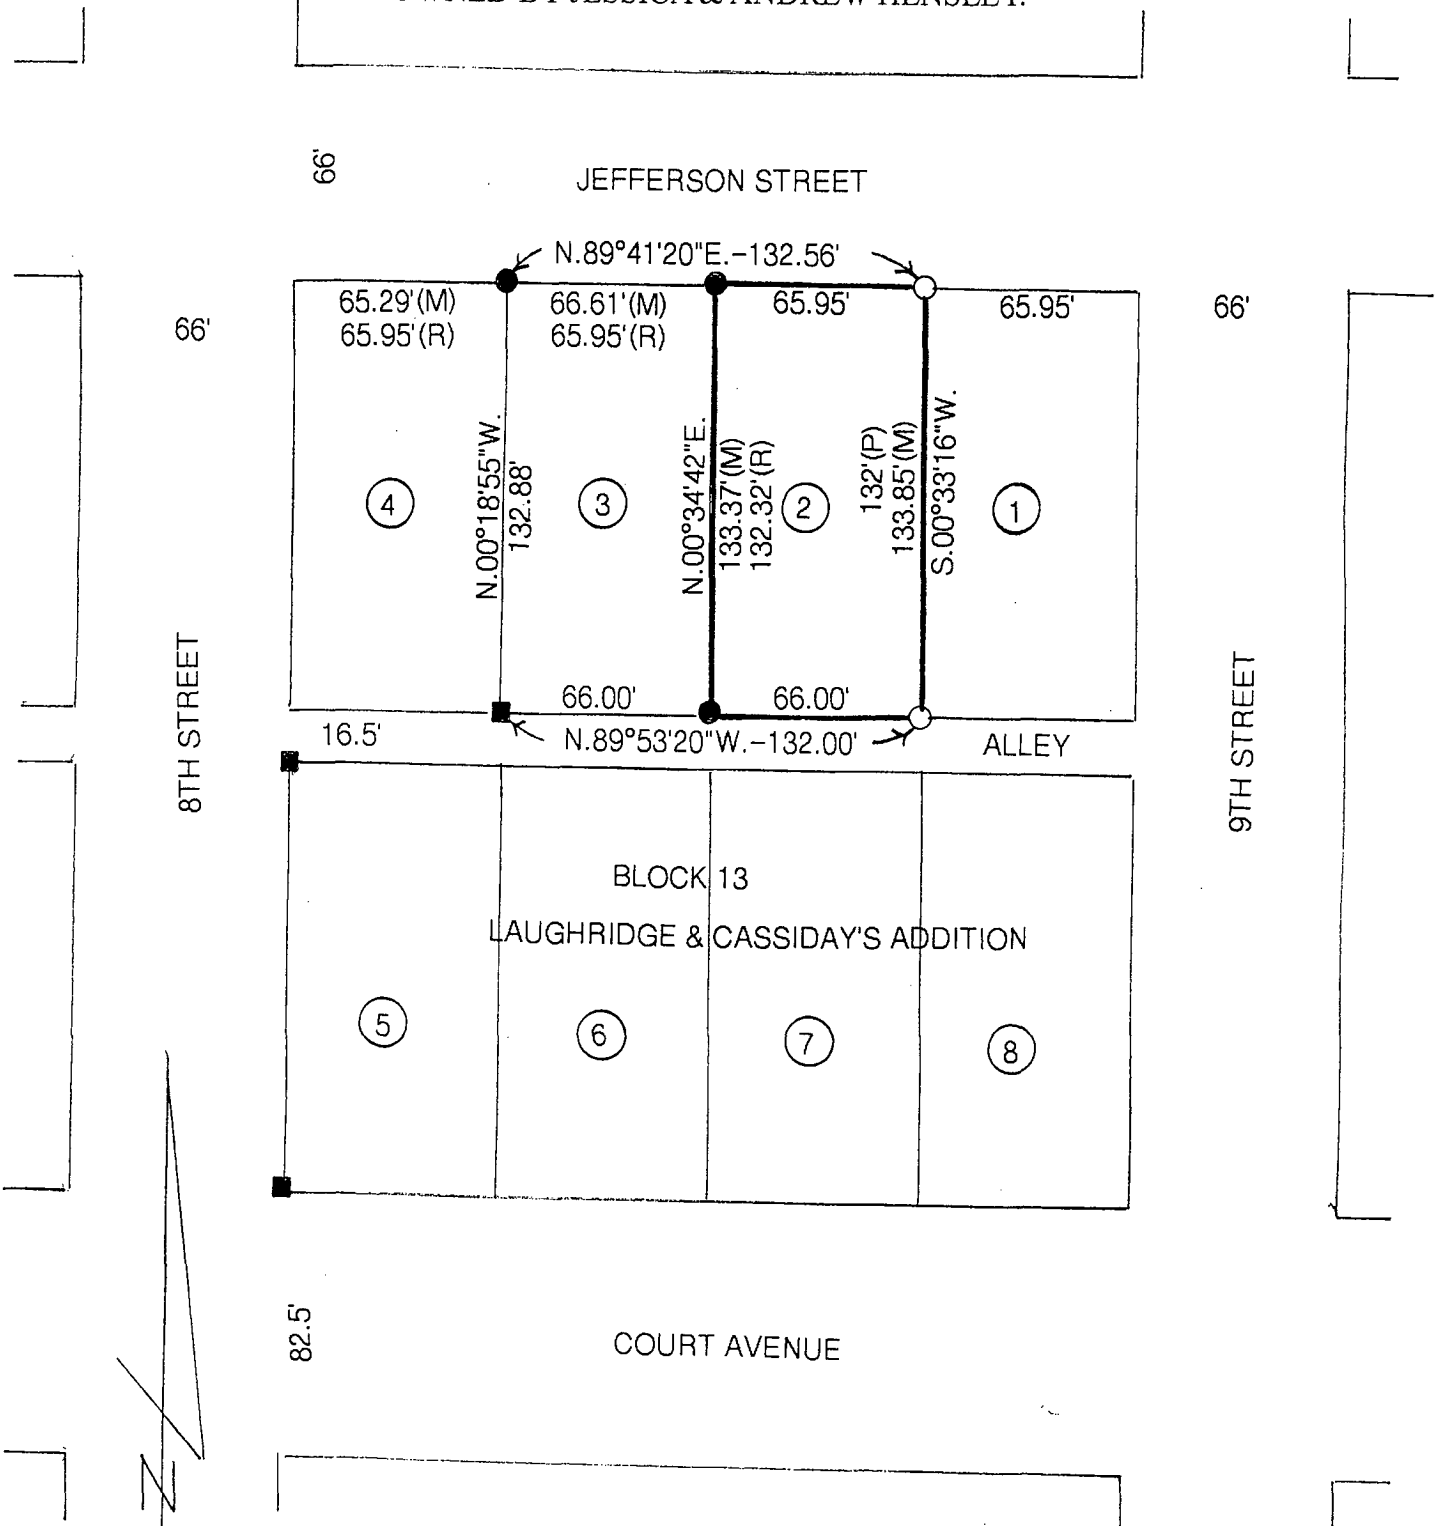

DATE OF SURVEY: 11-2-2015  
 ○ CAPPED IRON ROD (CIR) #6808 SET  
 ● CIR #5041 FOUND SPIKE FOUND  
 (M) MEASURED DIMENSION  
 (P) PLATTED DIMENSION

**LICENSED LAND SURVEYOR**  
 J. M. HOCHSTETLER  
 #6808  
 IOWA

I hereby certify that this land surveying document was prepared and the related survey work was performed by me or under my direct personal supervision and that I am a duly licensed Land Surveyor under the laws of the State of Iowa.

*J.M. Hochstetler*  
 J.M. HOCHSTETLER  
 License number 6808 Date 11/27/15  
 My license renewal date is December 31, 2015  
 Pages or sheets covered by this seal: 1