



Document 2015 3569

Book 2015 Page 3569 Type 06 026 Pages 1
Date 11/30/2015 Time 3:46:06PM
Rec Amt \$7.00

INDX
ANNO
SCAN
CHEK


LISA SMITH, COUNTY RECORDER
MADISON COUNTY IOWA

VANCE & HOCHSTETLER, P.C. • CONSULTING ENGINEERS • WINTERSET, IOWA 50273

CHARLES T. VANCE • 110 WEST GREEN ST., WINTERSET, IOWA • (515) 462-3995
JAMES M. HOCHSTETLER • 110 WEST GREEN ST., WINTERSET, IOWA • FAX: (515) 462-9845

PLAT OF SURVEY OF LOT 38, HONORS ACRES, SECOND ADDITION,
CITY OF WINTERSET, MADISON COUNTY, IOWA
OWNED BY DAVID & DONNA SCHRÖDT.

0
50'
100'
DATE OF SURVEY: 10-27-2015
O CAPPED IRON ROD (CIR) #68808 SET
▲ 1/2" IRON ROD FOUND
CIR #5041 FOUND
(M) MEASURED DISTANCE
(P) PLATTED DISTANCE

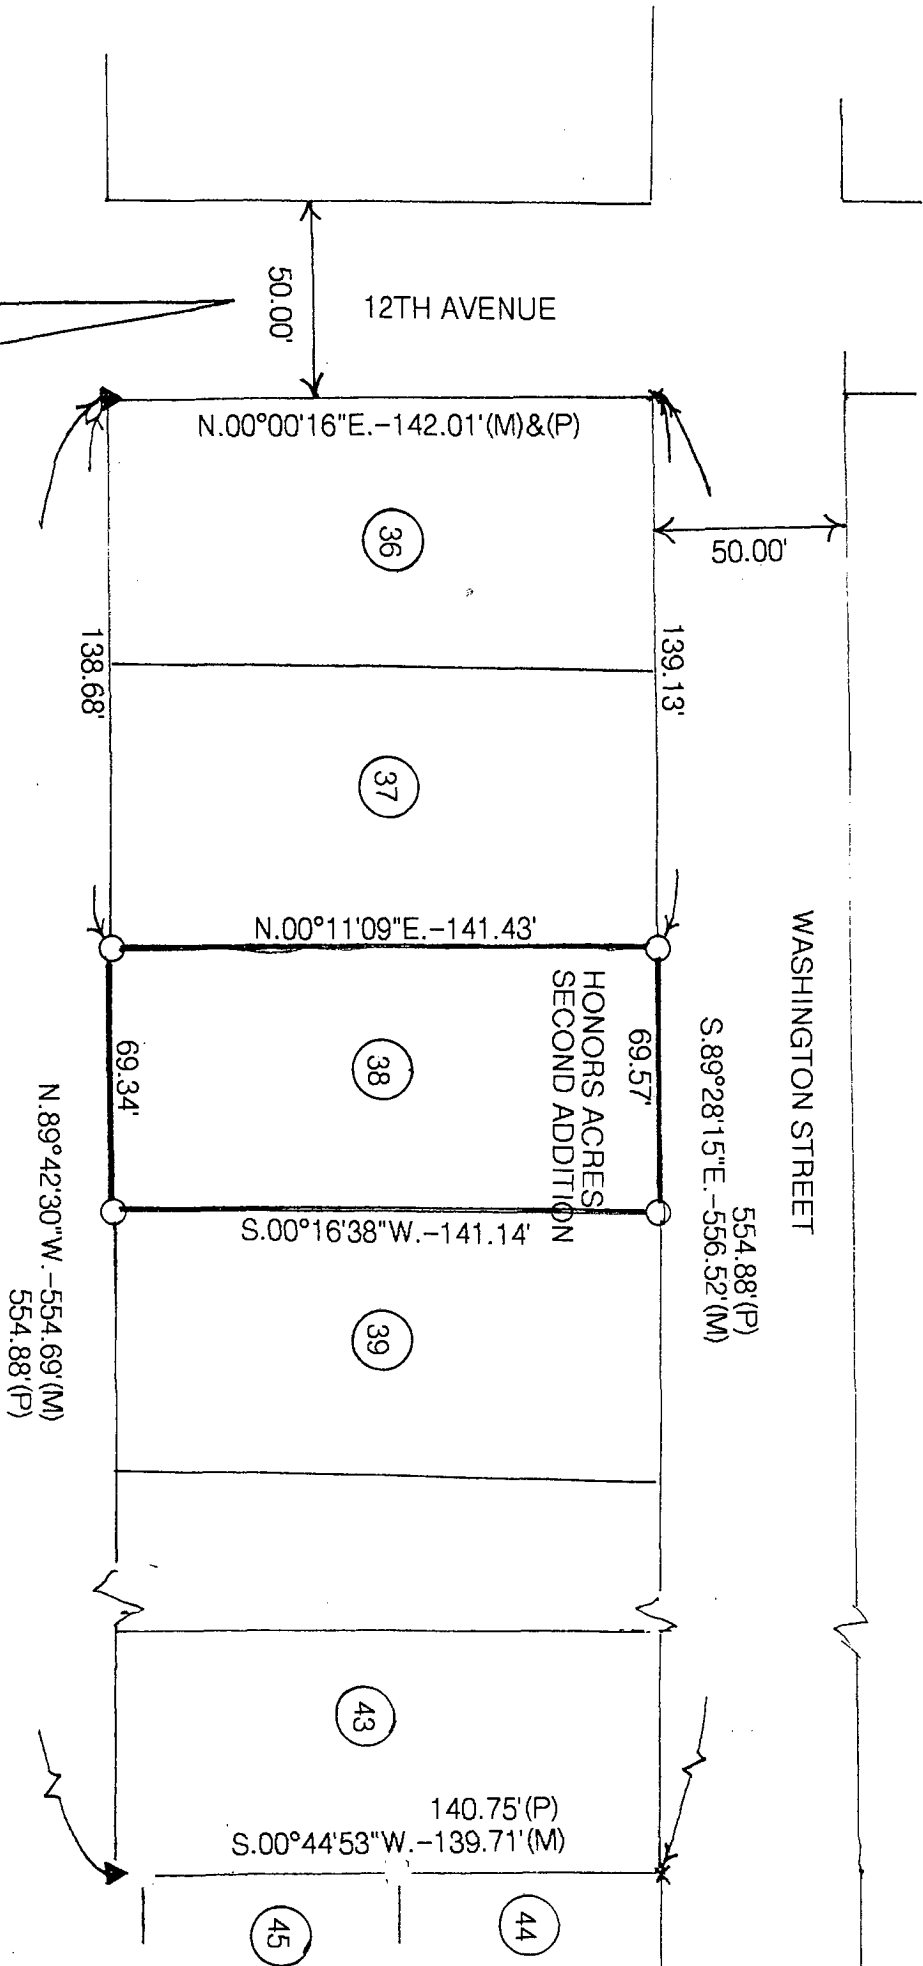

LICENSED LAND SURVEYOR
J. M. HOCHSTETLER
#6808
IOWA

I hereby certify that this land surveying document was prepared and the related survey work was performed by me or under my direct personal supervision and that I am a duly licensed Land Surveyor under the laws of the State of Iowa.

J.M. HOCHSTETLER
License number 6808 Date 11/25/15
My license renewal date is December 31, 2015.
Pages or sheets covered by this seal: 1