Document 2015 3547

Book 2015 Page 3547 Type 06 043 Pages 1
Date 11/25/2015 Time 3:15:02PM
Rec Amt $7.00

INDX ✓
ANNO
SCAN

LISA SMITH, COUNTY RECORDER
MADISON COUNTY IOWA

CHEK

15-191

VANCE & HOCHSTETLER, P.C., CONSULTING ENGINEERS, WINTERSET, IOWA (515) 462-3995
CHARLES T. VANCE, 110 West Green St., Winterset, Iowa, 50273
JAMES M HOCHSTETLER, 110 West Green St., Winterset, Iowa 50273

UNITED STATES PUBLIC LAND SURVEY CORNER CERTIFICATE

OF


Land Survey Monuments situated in Section 25, Township 76, Range 28, of the Fifth Principal Meridian, MADISON County, Iowa.
Previously recorded in _____ in County Recorder's Office.
(book, page, document number, etc.)

(Show reason for preparing this certificate, the evidence and detailed procedures used in establishing the the corner positions and monumentation found or placed.)

Monument Description and Remarks: SE COR NE¼ SW¼ - Set yellow CIR #6808 at midpoint on line between S¼ Cor and Center

PLAN - VIEW

(Show a minimum of three reference ties to durable physical objects, relevant monuments and physical conditions that will enable recovery of the corner.)

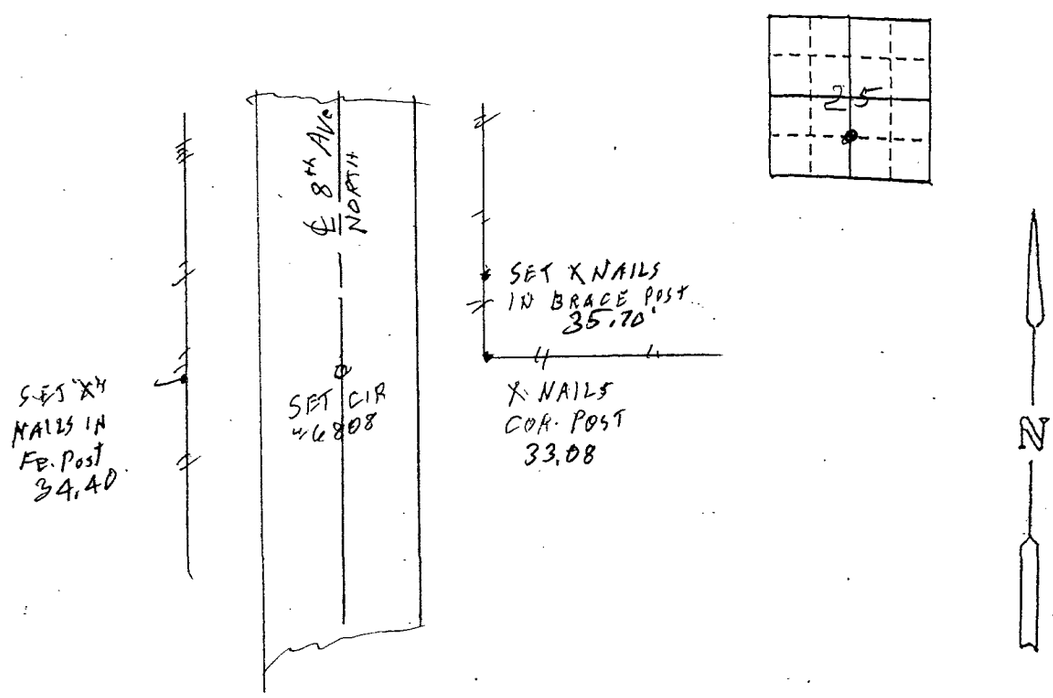

I hereby certify that this land surveying document was prepared and the related survey work was performed by me or under my direct personal supervision and that I am a duly licensed Land Surveyor under the laws of the State of Iowa.

J.M. HOCHSTETLER
License number 6808 Date 11/4/15
My license renewal date is December 31, 2015
Pages or sheets covered by this seal: 1

LICENSED LAND SURVEYOR J. M. HOCHSTETLER #6808 IOWA

List Corners to be Indexed

Corners	Section	Twp	Range
SE COR NE¼ SW¼	25	76	28