Document 2015 3763

Book 2015 Page 3763 Type 06 026 Pages 1
Date 12/22/2015 Time 9:43:00AM
Rec Amt $7.00

INDX ✓
ANNO ✓
SCAN

LISA SMITH, COUNTY RECORDER
MADISON COUNTY IOWA

CHEK

DANIELS LAND SURVEYING, 22598 18TH AVE, NEW VIRGINIA, IA 50210 515-577-2583

RETRACEMENT SURVEY

N 1/2 OF THE SW 1/4, SEC. 13, T 77N, R 27W
MADISON COUNTY, IOWA

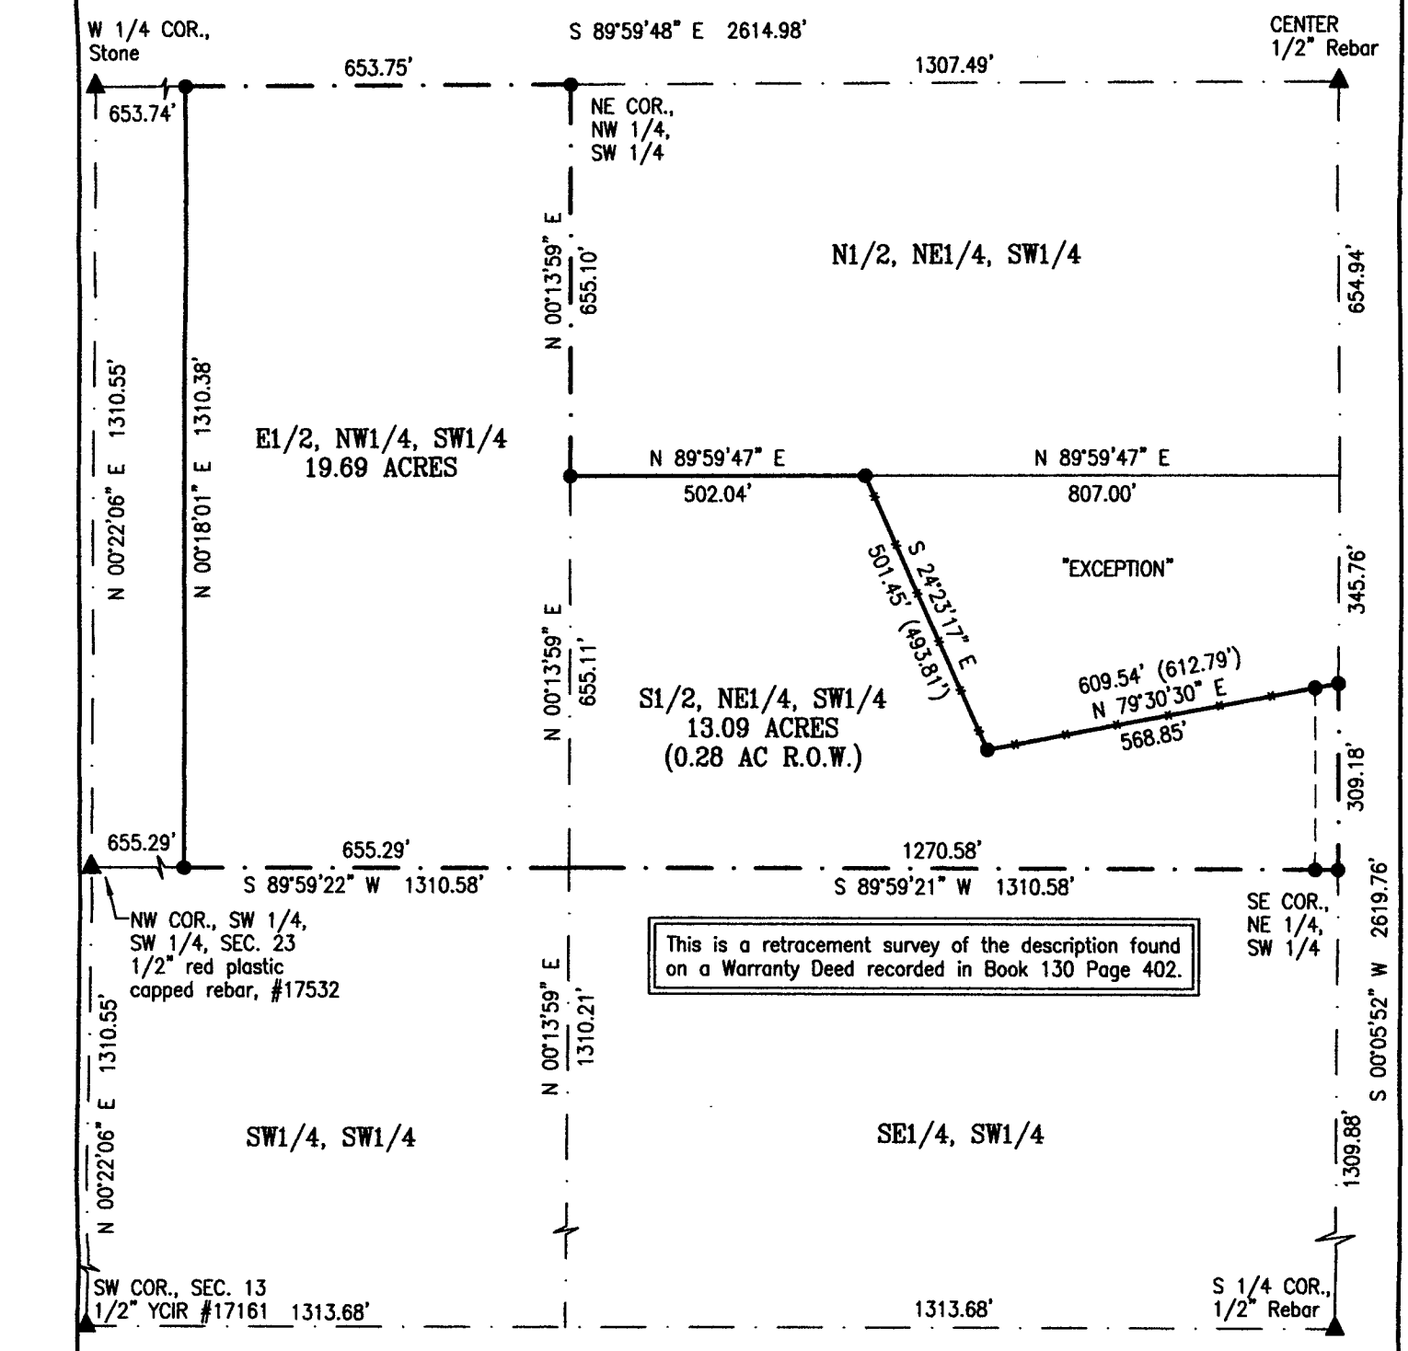

BASIS OF BEARINGS IS IA RCS ZONE 8

( ) – Recorded Distance/Bearing
– – – – – County Road Easement
— · — · — Section line

Monuments

▲ – Found section corner
● – Set 1/2" red plastic capped rebar, #17532

LICENSED LAND SURVEYOR
CHAD A. DANIELS
17532
IOWA

I hereby certify that this surveying document was prepared by me and the related survey work was performed by me or under my direct personal supervision and that I am a duly licensed Land Surveyor under the laws of the State of Iowa.

Signed _____ 12/18/2015
Chad A. Daniels Date

Iowa License No. 17532
My license renewal date is 12-31-2016
Page No.'s covered by this seal: 1

SURVEY FOR AND OWNER: Rosalie Dunham, 1265 Badger Creek Rd, Van Meter IA 50261

PROJ. NO. 692 DATE OF SURVEY: 12/15/2015 PAGE 1 of 1