Document 2016 25

Book 2016 Page 25 Type 06 043 Pages 1
Date 1/05/2016 Time 12:19:15PM
Rec Amt $7.00

INDX ✓
ANNO
SCAN

LISA SMITH, COUNTY RECORDER
MADISON COUNTY IOWA

CHEK

VANCE & HOCHSTETLER, P.C., CONSULTING ENGINEERS, WINTERSET, IOWA (515) 462-3995
CHARLES T. VANCE, 110 West Green St., Winterset, Iowa, 50273
JAMES M HOCHSTETLER, 110 West Green St., Winterset, Iowa 50273

# UNITED STATES PUBLIC LAND SURVEY CORNER CERTIFICATE

OF


Land Survey Monuments situated in Section 19, Township 77 N, Range 29 W, of the Fifth Principal Meridian, MADISON County, Iowa.
Previously recorded in _____ in County Recorder's Office.
(book, page, document number, etc.)


(Show reason for preparing this certificate, the evidence and detailed procedures used in establishing the the corner positions and monumentation found or placed.)

Monument Description and Remarks: NE Cor - Found bolt approximately 8" deep in middle of County Road intersection. N¼ Cor. - Found ½" Iron Rod in line with old property line fence North. Pin was 3" deep

## PLAN - VIEW

(Show a minimum of three reference ties to durable physical objects, relevant monuments and physical conditions that will enable recovery of the corner.)

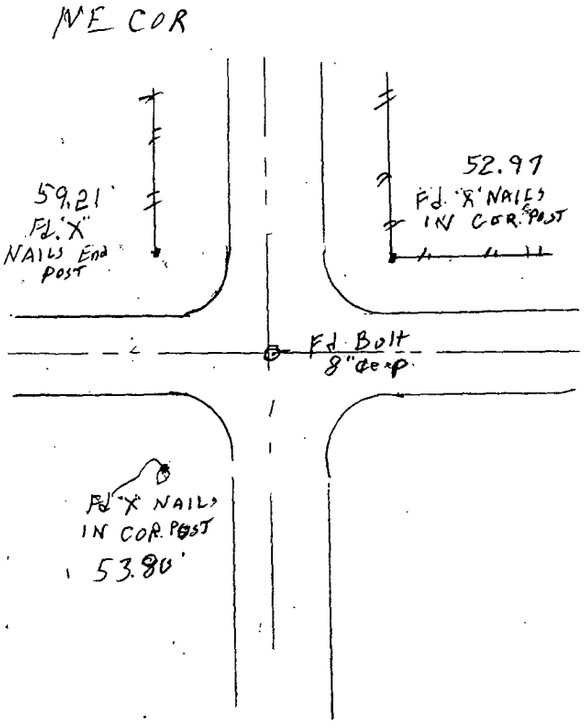

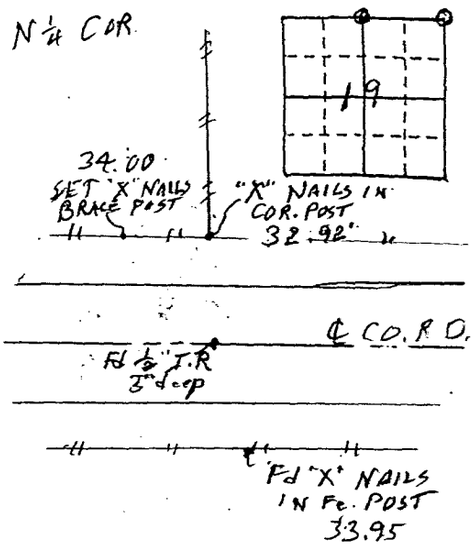
I hereby certify that this land surveying document was prepared and the related survey work was performed by me or under my direct personal supervision and that I am a duly licensed Land Surveyor under the laws of the State of Iowa.

LICENSED LAND SURVEYOR
J. M. HOCHSTETLER
#6808
IOWA

J.M. HOCHSTETLER
License number 6808 Date 12/22/15
My license renewal date is December 31, 2017
Pages or sheets covered by this seal: 1

List Corners to be Indexed

| Corners | Section | Twp | Range |
|---|---|---|---|
| NE COR | 19 | 77N | 29W |
| N¼ COR | 19 | 77N | 29W |