

Document 2016 562

Book 2016 Page 562 Type 06 026 Pages 1 Date 3/07/2016 Time 10:05:42AM


Rec Amt \$7.00

V INDX ✓ ANNO **SCAN**

LISA SMITH, COUNTY RECORDER MADISON COUNTY IOWA

CHEK

PAGE 1 of

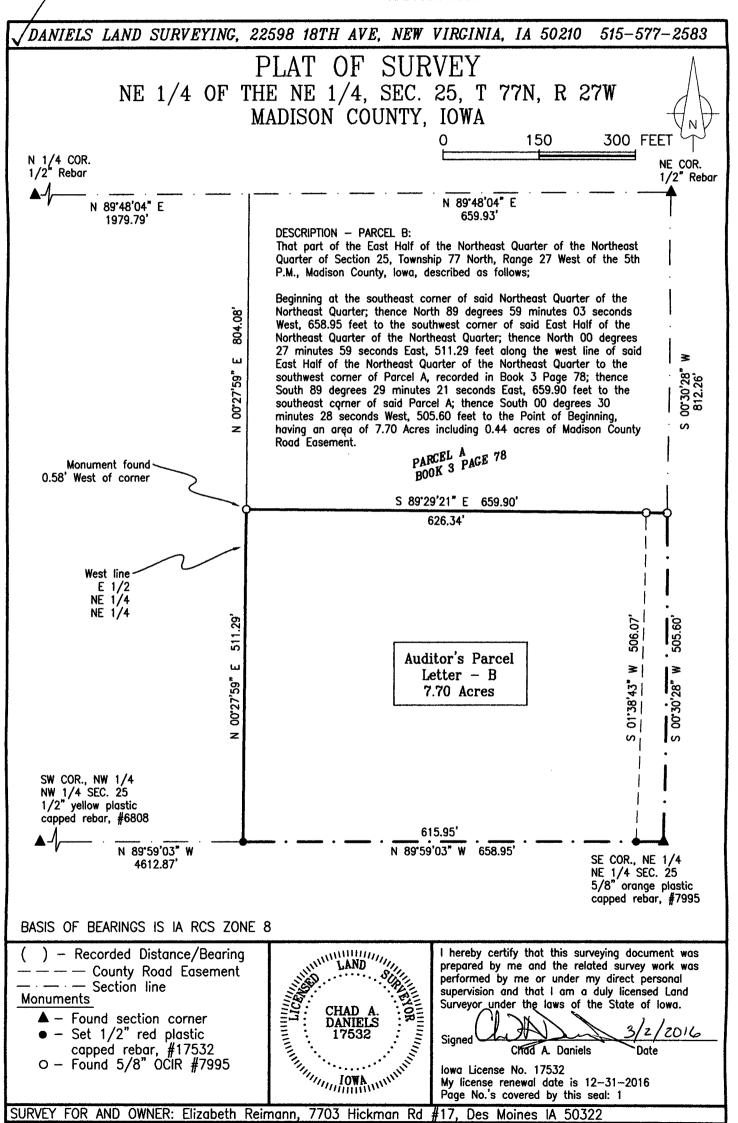

DATE OF SURVEY:

PROJ. NO. 711