



Document 2016 1051

Book 2016 Page 1051 Type 06 026 Pages 1  
Date 4/25/2016 Time 11:23:25AM  
Rec Amt \$7.00

INDX ✓  
ANNO  
SCAN  
CHEK

LISA SMITH, COUNTY RECORDER  
MADISON COUNTY IOWA


ABACI CONSULTING INC, 101 NE CIRCLE DR., GRIMES, IA 50111, PH.(515)986-5048

**BOUNDARY RETRACEMENT SURVEY**

SURVEY PREPARED FOR: Roger Johnson	DRAFTER: VP
OWNER: Roger & Angela Johnson Mallard Avenue Lorimar, Iowa	DATE: 4/19/16
	REVISION DATE:
	PROJECT NO: 16193

LEGAL DESCRIPTION:  
Parcel "C" of the NW Frc 1/4 of the NW 1/4  
Section 18 Township 74 North, Range 27 West  
of the 5th P.M., Madison Cunty, Iowa. As recorded  
in Book 2001 Page 2851 of the Madison County  
Recorder's Office.

DATE OF SURVEY FIELDWORK: 4/14/16

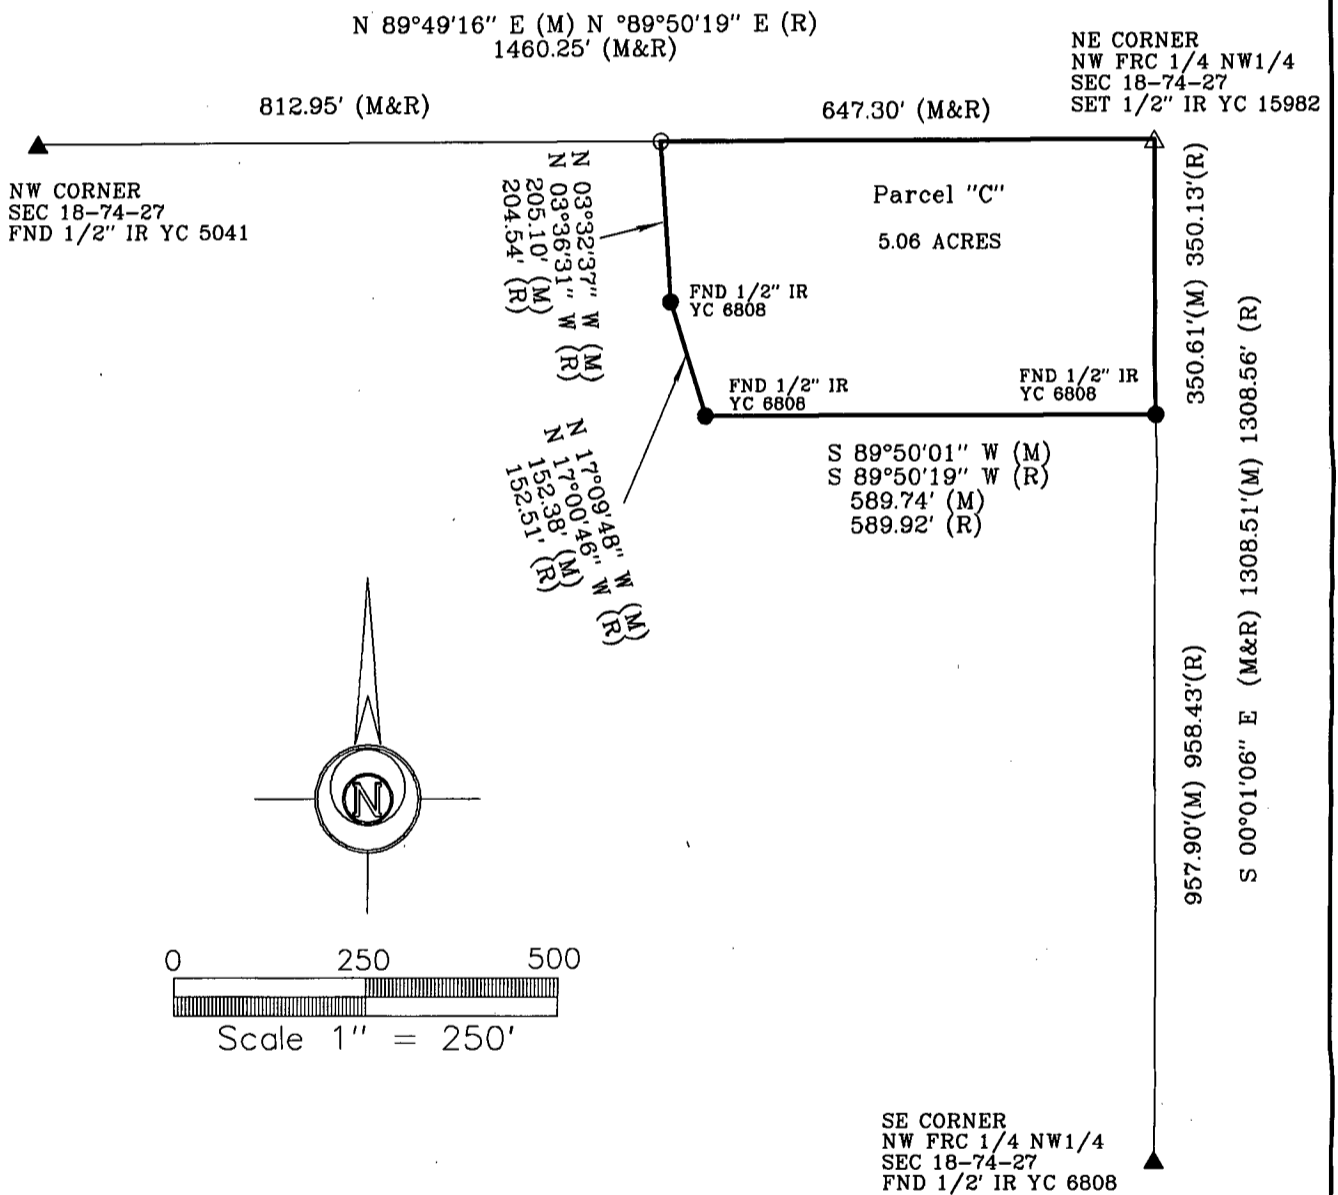


I HEREBY CERTIFY THAT THIS SURVEYING DOCUMENT WAS PREPARED AND THE RELATED WORK WAS PERFORMED BY ME OR UNDER MY DIRECT PERSONAL SUPERVISION, AND THAT I AM A DULY LICENSED PROFESSIONAL LAND SURVEYOR UNDER THE LAWS OF THE STATE OF IOWA.

*Vincent E. Piagentini* 4/20/16  
VINCENT E. PIAGENTINI, IOWA LIC. NO 15982 DATE

MY LICENSE RENEWAL DATE IS DECEMBER 31, 2016.

ADDITIONAL PAGES CERTIFIED (NONE UNLESS INDICATED HERE)

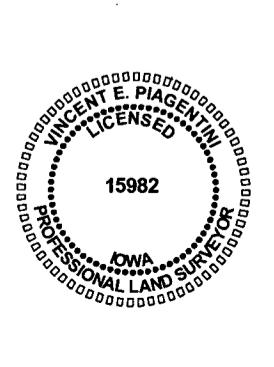

**SYMBOLS LEGEND:**

R. RECORDED DISTANCE  
M MEASURED DISTANCE  
● CORNER MONUMENT FOUND\*  
○ SET 1/2" IR YC 15982  
UNLESS NOTED  
▲ SECTION CORNER FOUND  
△ SECTION CORNER SET  
1/2" IR YC 15982

\* ALL CAPS ARE YELLOW PLASTIC UNLESS OTHERWISE INDICATED.

PROJECT NO: