

COMPUTER ✓  
RECORDED ✓  
DRAWN ✓

FILED NO. 5277

BOOK 3 PAGE 472


99 JUN 24 PM 2: 13

REC 5  
ADD  
DISE

MICHAEL L. OTTE  
RECORDER  
MADISON COUNTY, IOWA

VANCE & HOCHSTETLER, P C CONSULTING ENGINEERS, WINTERSSET, IOWA (515)462-3995  
CHARLES T VANCE 110 WEST GREEN ST, WINTERSSET, IOWA 50273  
JAMES M. HOCHSTETLER, 110 WEST GREEN ST, WINTERSSET, IOWA 50273

A PROPERTY LINE RETRACEMENT SURVEY FOR DENNIS F. ROLEK OF THE WEST LINE OF THE NORTHEAST QUARTER OF THE NORTHEAST QUARTER OF SECTION 22, THE WEST LINE OF THE EAST HALF OF THE SOUTHEAST QUARTER OF SECTION 15, AND THE NORTH LINE OF THE NORTHEAST QUARTER OF THE SOUTHEAST QUARTER OF SECTION 15 WEST OF THE EXISTING CHANNEL OF MIDDLE RIVER, TOWNSHIP 75 NORTH, RANGE 29 WEST OF THE 5th P.M., MADISON COUNTY, IOWA.

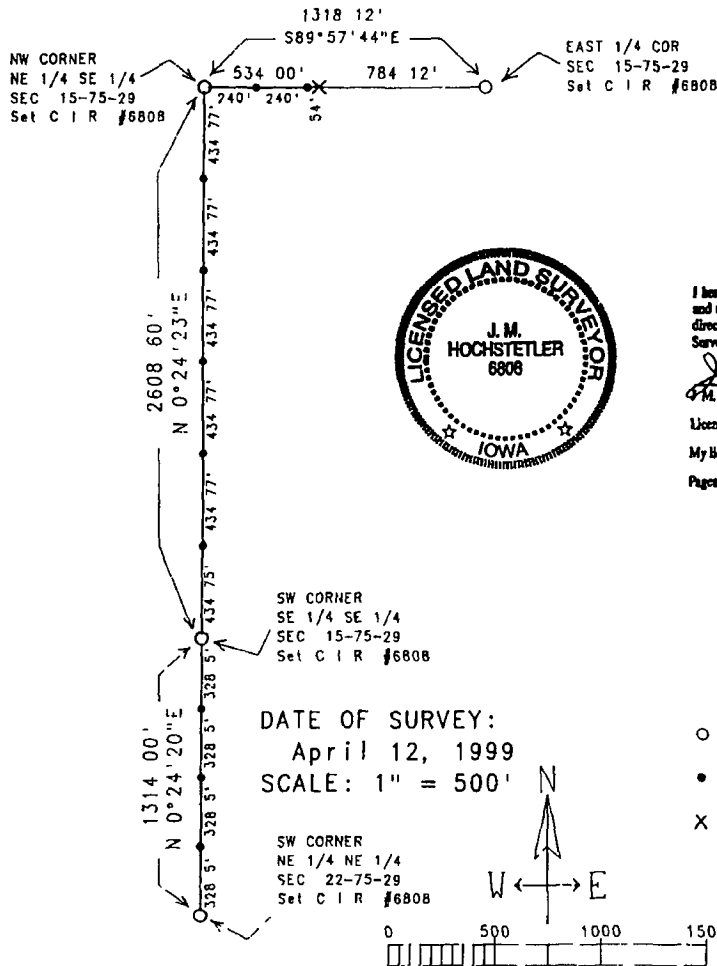

I hereby certify that this land surveying document was prepared and the related survey work was performed by me or under direct personal supervision and that I am a duly licensed Surveyor under the laws of the State of Iowa.

*J.M. Hochstetler*  
J.M. HOCHSTETLER

License number 6808 Date 6/24/99

My license renewal date is December 31 1999

Pages or sheets covered by this seal 1

LEGEND

- Set Capped Iron Rod (C I R #6808)
- Set 3/4" Rebar painted orange (point on line)
- X No Monument Set (Middle River)