

REC # 50  
AUD #  
R.M.F. # 1.00

FILED NO. 3545  
BOOK 3 PAGE 196



COMPUTER ✓  
RECORDED ✓  
COMPARED

98 MAR 19 AM 11:03  
MICHELLE UELL  
RECORDER  
MADISON COUNTY, IOWA

**VANCE & HOCHSTETLER, P.C. CONSULTING ENGINEERS, WINTERSSET, IOWA (615)462-3995**

**CHARLES T. VANCE, 110 WEST GREEN ST., WINTERSSET, IOWA 50273**  
**JAMES M. HOCHSTETLER, 110 WEST GREEN ST., WINTERSSET, IOWA 50273**

A PLAT OF SURVEY FOR STEVE AGAN LOCATED IN THE SOUTHWEST QUARTER OF THE NORTHEAST QUARTER OF SECTION 6, TOWNSHIP 74 NORTH, RANGE 27 WEST OF THE 5th P.M., MADISON COUNTY, IOWA.

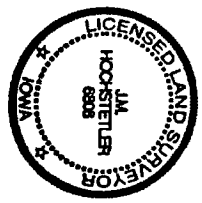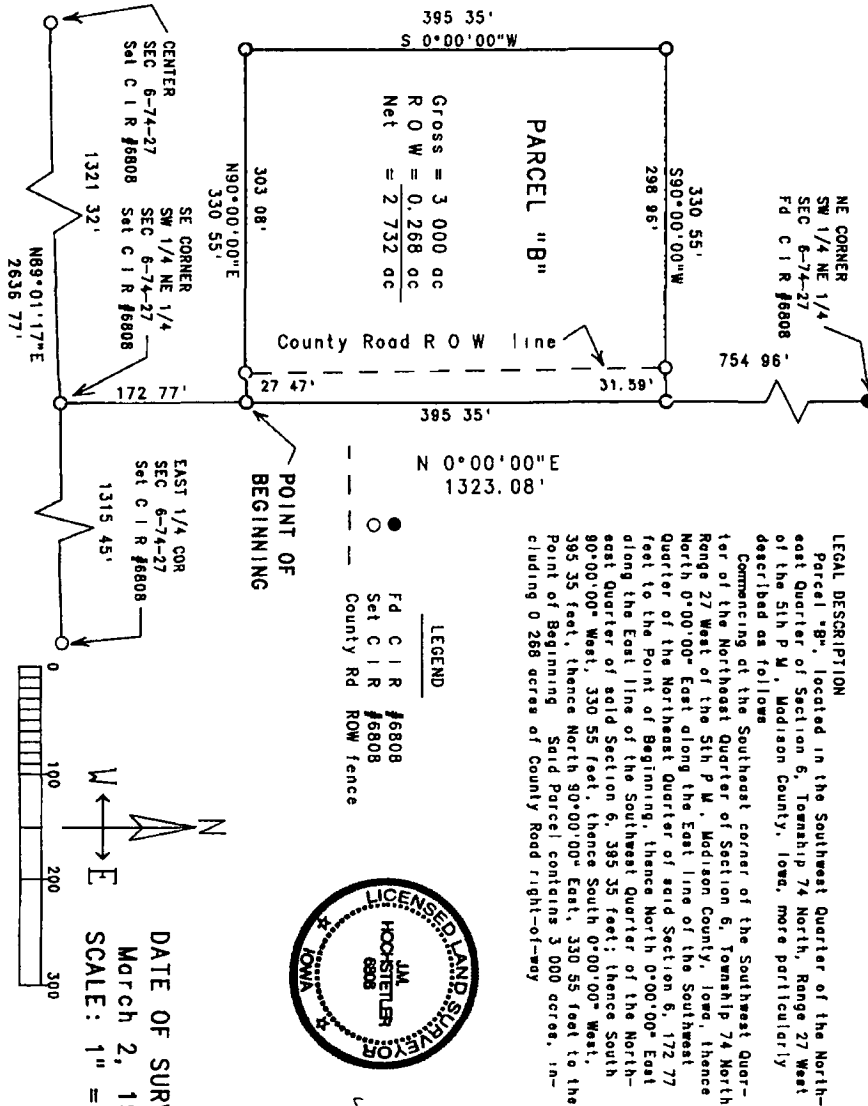

I hereby certify that this land surveying instrument was prepared and the actual surveying work was performed by me or under my direct personal supervision and that I am a duly Licensed Land Surveyor under the laws of the State of Iowa.

*James M. Hochstetler*  
J.M. HOCHSTETLER  
License number 6808  
Date: 3/3/98  
By: James M. Hochstetler  
Page or pages covered by this seal: 1